

HARRISON
0144
4-26-66
Date: 4/26, 1966

WATER WELL DRILLERS LOG

CODED

Driller: Hattiesburg Butane County
(Name)

(1) Owner of Land: Charles V. Loftis
(Name)
Long Beach
(Address)

(2) Location: 1/4, 1/3, 812
Commission Road
_____ miles _____ of _____
(distance) (direction) (Nearest Town)

(3) Topography: _____
(Hilly) (Flat) (Level)

(4) Purpose of Well: Domestic
(Domestic Irrigation
Municipal, Industrial, Other)

Description & Color of Materials Sand, Clay, Red Clay, Shell, etc.	Thick- ness Feet	Depth Feet
<u>Red Clay</u>	<u>0</u>	<u>15</u>
<u>Blue clay</u>	<u>15</u>	<u>105</u>
<u>Blue sand</u>	<u>105</u>	<u>110</u>
<u>Blue clay</u>	<u>110</u>	<u>198</u>
<u>Blue sand</u>	<u>198</u>	<u>203</u>

Information upon completion of well:

(1) Diameter 2 inches.

(2) Total Depth 203 feet.

(3) Water Level 12 feet below top of ground.

(4) Cased to _____, Size _____

(5) Screen: Size 2", Length 10'


(6) Were any formations sealed against pollution?
_____ yes, no.

CODED

If YES depth of formation _____

Why _____

Drillers Remarks: _____

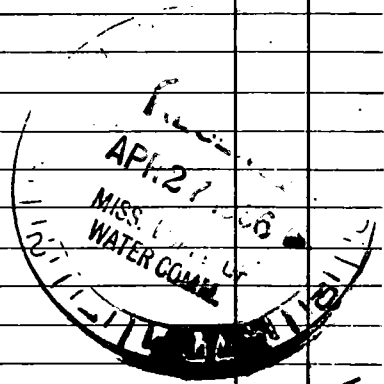

(Use Back Side)

Well No.







