HARRISON
Ø251
2-25-75
E Log #109

GW 08056

MISSISSIPPI
BOARD OF WATER COMMISSIONERS
416 North State Street
Jackson, Mississippi 39201

WATER WELL DRILLERS LOG

Feb 25 1975 19 Switzer Well Co. Harrison
date well completed — firm name — county well located

LANDOWNER: Royal Estates Sub.
Coast Water Works Inc.
120 Pass Road, Biloxi, Miss
(mailing address)

WELL LOCATION:
sec. 11 T 8 S R 12 W 13-5
2 (distance) miles N (direction) of Long Beach (nearest town)

WELL PURPOSE: Municipal
(home, irrigation, municipal, industrial)

WELL COMPLETION DATA:
(1) diameter (inches) 12"X8"
(2) total depth (feet) 850'
(3) static water level (feet) 9 below ~~above~~ top of ground
(4) casing Steel (material), 790 (depth), 12"X8" (size) If telescope see back.
(5) screen 60' (length), 790 (depth to top), 8" (size), Stainless Steel (material)
(6) pump 30 (HP) 500 (yield gpm)
Electric (type power)
(7) electric log yes (yes or no)
USGS (organization running log)
(8) how well bottom plugged Back wash Valve

DRILLERS REMARKS:

description of formations encountered	from	to
Surface Sand	0	20
Mixed Sand & Clay	20	40
Clay	40	100
Mixed Sand & Clay	100	120
Clay	120	320
Good Sand	320	388
Clay	388	434
Sand	434	472
Mixed Sand & Clay	472	556
Sand	556	586
Clay	586	680
Mixed Sand & Clay	680	716
Fair Sand	716	760
Good Sand	760	852

RECEIVED
MAR 24 1975
MISS. BD. OF WATER COMM.

If well telescopes please sketch and show depths.

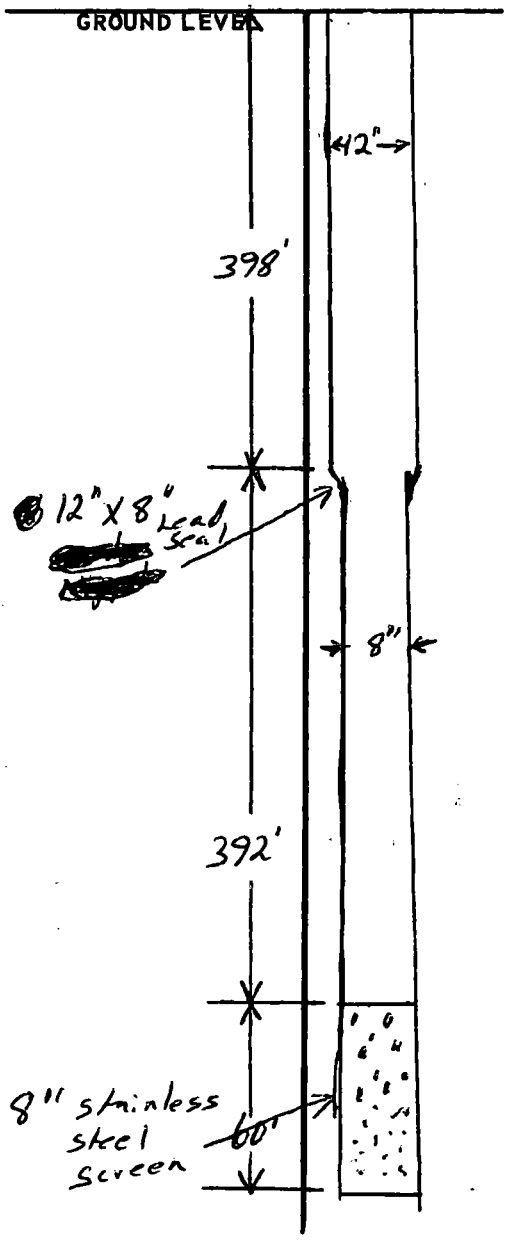

If more than one screen, show locations of each on sketch.

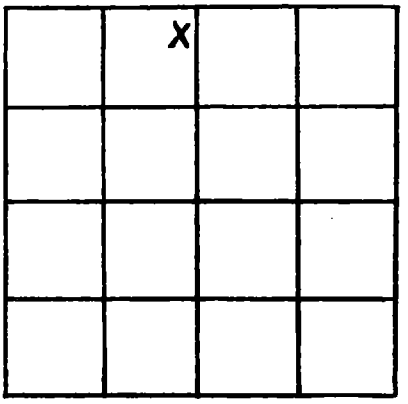

SECTION 11

Please indicate well location X.

ADDITIONAL INFORMATION