MISSISSIPPI DEPARTMENT OF ENVIRONMENTAL QUALITY
Office of Land and Water Resources

P. O. Box 10631
Jackson, MS 39289-0631
WATER WELL DRILLERS LOG

COUNTY WELL LOCATED: Harrison	PERMIT NUMBER: 0404
WELL NUMBER: 320 CODED	NAME OF DRILLING FIRM: Lyman Well Company
DATE WELL COMPLETED: 5-3-95	Gulfport, Ms 39503

NAME & MAILING ADDRESS OF LANDOWNER
Ms. Gulf Coast Community College
West Harrison Occupational Training Center
Long Beach, Ms 39560

WELL LOCATION	SEC	TOWNSHIP	RANGE
	9	8 N (S)	12 E (W)

DISTANCE	DIRECTION	NEAREST TOWN
Miles 7	N	of Long Beach

OTHER LANDMARK

WELL PURPOSE: Home, Irrigation, Municipal, Industrial, Fish Pond, etc.

PUMP DATA

PUMP TYPE (Circle One): Submersible, Turbine, Jet, Flowing Well, Other (Describe)

POWER TYPE (Circle One): Electric, Tractor, Diesel, Gasoline, Butane, Other (Describe) H/P

Pump Capacity (GPM)	No. of Stages	Setting Depth
		FT.

PUMP TEST

Well yielded 200 GPM with a drawdown of NJ ft. after NA hours of pumping

WELL DATA

Well Depth	Casing Diameter (In.)	Casing Length (Ft.)
1860	4"	1830

Type of Casing	Hole Depth	Depth to Static Water Level
PVC	1866	+30

TYPE OF COMPLETION: (Circle One or More): Gravel Packed, Underreamed, Telescoped, Natural Development, Open Hole, Other (Describe)

WELL GROUTED TO A DEPTH OF 20 FEET
Type Grout (circle one): Cement, Bentonite, or Mix

LOG DATA

TYPE OF LOG RUN (Circle One): No Log Run, Electric, Gamma Ray, Density, Sonic, Neutron, Other (Describe)

Name of Organization Running Log

GEOLOGIC DATA

Surface Elev.	Date	Analysis	Depth of Top
Subs. SWL	Date	Analysis	Aquifer Test

Driller's Remarks

RECEIVED
MAY 05 1995
Dept. of Environmental Quality
Office of Land & Water Resources

Top of Lap Pipe or Reduction in Casing FEET

IF TELESCOPED OR MORE THAN ONE SCREEN: USE BACK PAGE

SCREEN DATA

Diameter - Inches	Length - Feet	Slot Size - Inches
4"	30'	.008

Screen Type	Depth to Bottom - Feet
Sawed	1860

DESCRIPTION OF FORMATIONS ENCOUNTERED	FROM	TO
yellow clay	0	9
White Sand	9	60
Blue clay	60	320
Sand fine	320	350
Blue clay	350	740
Sand	740	830
Blue clay	830	860
Sand	860	980
Blue with Brown clay	980	1140
Sea shell	1140	1190

FORMATIONS (Continued)	FROM	TO
Red clay & Brown	1190	1360
Rock	1360	1390
Very sticky clay sand	1390	1740
Sand	1740	1866

IF MORE SPACE IS NEEDED USE BACK

If well telescopes please sketch and show depths.

GROUND LEVEL

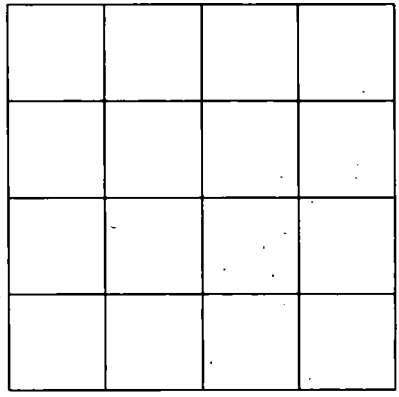

SECTION _____

Please indicate well location X.

ADDITIONAL INFORMATION

MAY 05 1995

If more than one screen, show location of each on sketch.