MISSISSIPPI DEPARTMENT OF NATURAL RESOURCES

Bureau of Land and Water Resources

P.O. Box 10631
Jackson, Mississippi 39209

WATER WELL DRILLERS LOG

COUNTY WELL LOCATED: Harrison

WELL NUMBER: Ø 2120 CODED

DATE WELL COMPLETED: 5-17-87

PERMIT NUMBER: 0-239

NAME OF DRILLING FIRM: MCGILL PUMP & WELLS
~~RT1 BOX 1643 CANAL RD~~
GULPT, MS 39503

NAME & MAILING ADDRESS OF LANDOWNER: Mrs. Sherrot
Arcadia
Pass Chr, Miss.

WELL LOCATION: SEC 8 TOWNSHIP 8 N (S) RANGE 12 E (W)

DISTANCE 1 Miles DIRECTION North of NEAREST TOWN Pineville

OTHER LANDMARK

WELL PURPOSE: (Home) Irrigation, Municipal, Industrial, Fish Pond, etc.

PUMP DATA

PUMP TYPE (Circle One): (Submersible) Turbine, Jet Flowing Well, Other (Describe)

POWER TYPE (Circle One): (Electric) Tractor, Diesel, Gasoline, Butane, Other (Describe)

Pump Capacity (GPM)	No. of Stages	Setting Depth
18-25	14	80 FT.

PUMP TEST

Well yielded 20 GPM with a drawdown of 10 ft. after 1 hours of pumping

WELL DATA

Well Depth	Casing Diameter (In.)	Casing Length (Ft.)
560' ~~500'~~	4 1/2	20

Type of Casing	Hole Depth	Depth to Static Water Level
PVC	~~500'~~ 560'	25'

TYPE OF COMPLETION: (Circle One or More): Gravel Packed, Underreamed, Telescoped, (Natural Development) Open Hole, Other (Describe)

Top of Lap Pipe or Reduction in Casing FEET

IF TELESCOPED OR MORE THAN ONE SCREEN: USE BACK PAGE

LOG DATA

TYPE OF LOG RUN (Circle One): (No Log Run) (Electric) Gamma Ray, Density, Sonic, Neutron, Other (Describe)

Name of Organization Running Log

GEOLOGIC DATA (Office Use Only)

Surface Elev.	Geologic Unit	Unit Thickness	Depth to Top
Subs. SWL	Date	Analysis	Aquifer Test

Driller's Remarks

SCREEN DATA

Diameter - Inches	Length - Feet	Slot Size - Inches
2"	20'	.0006

Screen Type	Depth to Bottom - Feet
Sch 80 PVC	

DESCRIPTION OF FORMATIONS ENCOUNTERED	FROM	TO
Mud	0'	20
Sand	20	60
Mud	60	370
Sand	370	380
Mud	380	520
Sand	520	560

FORMATIONS (Continued)	FROM	TO

RECEIVED
MAY 27 1987
Department of Natural Resources
Bureau of Land & Water Resources

IF MORE SPACE IS NEEDED, USE BACK

If well telescopes please sketch and show depths.

GROUND LEVEL

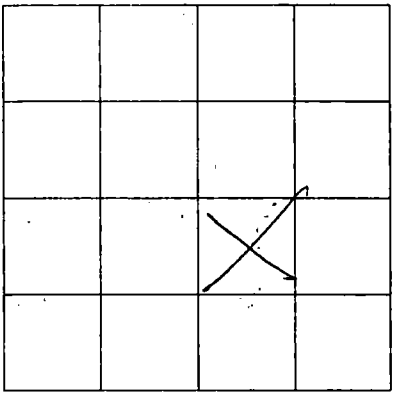

SECTION _____

Please indicate well location X.

ADDITIONAL INFORMATION

If more than one screen, show location of each on sketch.