MISSISSIPPI DEPARTMENT OF NATURAL RESOURCES

Bureau of Land and Water Resources

P.O. Box 10631
Jackson, Mississippi 39209

WATER WELL DRILLERS LOG

COUNTY WELL LOCATED	Harrison
WELL NUMBER	Φ 2/8
CODED	2
PERMIT NUMBER	0239
NAME OF DRILLING FIRM	McGill Pump & Well
DATE WELL COMPLETED	Sept. 3-87
	1643 Lpt. Ms. Canal rd.

NAME & MAILING ADDRESS OF LANDOWNER: Ricky Cross, 6455 Simmons rd, Lpt. Ms.

WELL LOCATION: SEC 4 TOWNSHIP 8 N (S) RANGE 12 E (W)

DISTANCE 4 Miles DIRECTION West of NEAREST TOWN Lpt.

OTHER LANDMARK

WELL PURPOSE: (Home), Irrigation, Municipal, Industrial, Fish Pond, etc.

PUMP DATA

PUMP TYPE (Circle One): Submersible, Turbine, (Jet), Flowing Well, Other (Describe)

POWER TYPE (Circle One): (Electric), Tractor, Diesel, Gasoline, Butane, Other (Describe)

Pump Capacity (GPM)	No. of Stages	Setting Depth
12	2	25 FT.

PUMP TEST

Well yielded 12 GPM with a drawdown of 8 ft. after 1 hours of pumping

WELL DATA

Well Depth	Casing Diameter (In.)	Casing Length (Ft.)
260	2"	250
Type of Casing	**Hole Depth**	**Depth to Static Water Level**
PVC	260	5'

TYPE OF COMPLETION: (Circle One or More): Gravel Packed, Underreamed, Telescoped, (Natural Development), Open Hole, Other (Describe)

Top of Lap Pipe or Reduction in Casing FEET

IF TELESCOPED OR MORE THAN ONE SCREEN: USE BACK PAGE

LOG DATA

TYPE OF LOG RUN (Circle One): (No Log Run), Electric, Gamma Ray, Density, Sonic, Neutron, Other (Describe)

Name of Organization Running Log

GEOLOGIC DATA (Office Use Only)

Surface Elev.	Geologic Unit	Unit Thickness	Depth to Top
Subs. SWL	Date	Analysis	Aquifer Test

Driller's Remarks

SCREEN DATA

Diameter - Inches	Length - Feet	Slot Size - Inches
2"	10'	.0006
Screen Type		**Depth to Bottom - Feet**
PVC		260

DESCRIPTION OF FORMATIONS ENCOUNTERED	FROM	TO
Sand	0	50
Mud	50	200
Sand	200	260

FORMATIONS CONTINUED | FROM | TO

IF MORE SPACE IS NEEDED, USE BACK

RECEIVED
OCT 14 1987
Department of Natural Resources
Bureau of Land & Water Resources

If well telescopes please
sketch and show depths.

GROUND LEVEL

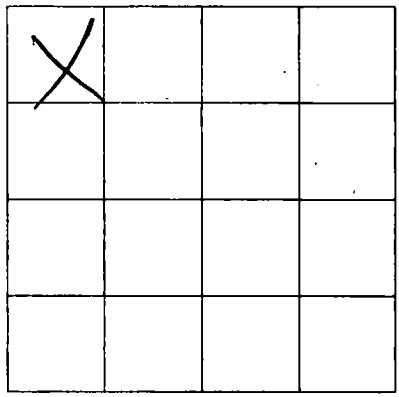

SECTION _____

Please indicate well location X.

ADDITIONAL INFORMATION

If more than one screen,
show location of each on sketch.