MISSISSIPPI DEPARTMENT OF NATURAL RESOURCES

Bureau of Land and Water Resources

P.O. Box 10631
Jackson, Mississippi 39209

WATER WELL DRILLERS LOG

COUNTY WELL LOCATED: Harrison

WELL NUMBER: Φ 2211 CODED

DATE WELL COMPLETED: Nov. 1-1988

PERMIT NUMBER: 0-239

NAME OF DRILLING FIRM: McGill Pump + Wells

NAME & MAILING ADDRESS OF LANDOWNER: David Allen/Edward Reid

WELL LOCATION: SEC 17 TOWNSHIP 8 (N) (S) RANGE 12 (E) (W)

DISTANCE 1 Miles DIRECTION South of NEAREST TOWN Pineville

OTHER LANDMARK

WELL PURPOSE: Home, Irrigation, Municipal, Industrial, Fish Pond, etc.: Home

PUMP DATA

PUMP TYPE (Circle One): Submersible, Turbine, (Jet) Flowing Well, Other (Describe)

POWER TYPE (Circle One): (Electric) Tractor, Diesel, Gasoline, Butane, Other (Describe)

Pump Capacity (GPM)	No. of Stages	Setting Depth
15	2	40' FT.

PUMP TEST

Well yielded 15 GPM with a drawdown of 10 ft. after 1 hours of pumping

WELL DATA

Well Depth	Casing Diameter (In.)	Casing Length (Ft.)
620	2"	20'

Type of Casing	Hole Depth	Depth to Static Water Level
PVC	620	40'

TYPE OF COMPLETION: (Circle One or More): Gravel Packed, Underreamed, Telescoped, (Natural Development) Open Hole, Other (Describe)

Top of Lap Pipe or Reduction in Casing: FEET

IF TELESCOPED OR MORE THAN ONE SCREEN: USE BACK PAGE

SCREEN DATA

Diameter - Inches	Length - Feet	Slot Size - Inches
2"	10'	.0006

Screen Type	Depth to Bottom - Feet
PVC	600'

LOG DATA

TYPE OF LOG RUN (Circle One): (No Log Run) Electric, Gamma Ray, Density, Sonic, Neutron, Other (Describe)

Name of Organization Running Log

GEOLOGIC DATA (Office Use Only)

Surface Elev.	Geologic Unit	Unit Thickness	Depth to Top
Subs. SWL	Date	Analysis	Aquifer Test

Driller's Remarks

DESCRIPTION OF FORMATIONS ENCOUNTERED	FROM	TO
Sand	0	60
Mud	60	100
Sand	100	140
Mud	140	350
Sand	350	380
Mud	380	580
Sand	580	620

FORMATIONS PENETRATED	FROM	TO

IF MORE SPACE IS NEEDED, USE BACK

RECEIVED
NOV 30 1988
Department of Natural Resources
Bureau of Land & Water Resources

If well telescopes please sketch and show depths.

GROUND LEVEL

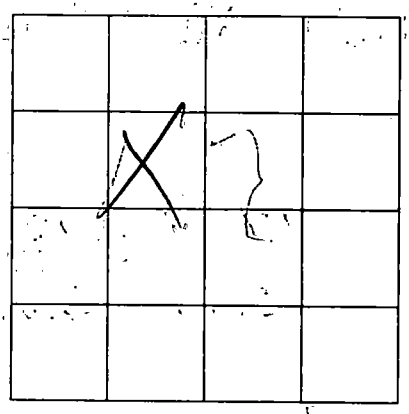

SECTION _____

Please indicate well location X.

ADDITIONAL INFORMATION

If more than one screen, show location of each on sketch.