MISSISSIPPI DEPARTMENT OF ENVIRONMENTAL QUALITY
Office of Land and Water Resources

P. O. Box 10631
Jackson, MS 39289-0631

WATER WELL DRILLERS LOG

COUNTY WELL LOCATED: Hancock	
WELL NUMBER: Q-2295	CODED:
DATE WELL COMPLETED: 2/27/01	
PERMIT NUMBER: 0-239	
NAME OF DRILLING FIRM: mc bill pump + well	

NAME & MAILING ADDRESS OF LANDOWNER
Marcel Sarreua
2 Second St
Pass Christian MS 39571

WELL LOCATION	SEC	TOWNSHIP	RANGE
	20	8 N/S	12 E/W

DISTANCE	DIRECTION	NEAREST TOWN
Miles	of	

OTHER LANDMARK

WELL PURPOSE: (Home) Irrigation, Municipal, Industrial, Fish Pond, etc.

PUMP DATA

PUMP TYPE (Circle One): Submersible, Turbine, Jet, Flowing Well, Other (Describe) Suction

POWER TYPE (Circle One): (Electric) Tractor, Diesel, Gasoline, Butane, Other (Describe) _____ H/P 1/2

Pump Capacity (GPM)	No. of Stages	Setting Depth
5	1	15 FT.

PUMP TEST

Well yielded 5 GPM with a drawdown of 3 ft. after 1 hours of pumping

WELL DATA

Well Depth	Casing Diameter (In.)	Casing Length (Ft.)
30	2	20

Type of Casing	Hole Depth	Depth to Static Water Level
PVC	30	5

TYPE OF COMPLETION: (Circle One or More): Gravel Packed, Underreamed, Telescoped, (Natural Development), Open Hole, Other (Describe) _____

WELL GROUTED TO A DEPTH OF 10 FEET
Type Grout (circle one): Cement, Bentonite, or Mix

LOG DATA

TYPE OF LOG RUN (Circle One): No Log Run, Electric, Gamma Ray, Density, Sonic, Neutron, Other (Describe) Hand drilled

Name of Organization Running Log

GEOLOGIC DATA (Office Use Only)

Surface Elev.	Geologic Unit	Unit Thickness	Depth to Top
Subs. SWL	Date	Analysis	Aquifer Test

Driller's Remarks

Top of Lap Pipe or Reduction in Casing
FEET — IF TELESCOPED OR MORE THAN ONE SCREEN: USE BACK PAGE

SCREEN DATA

Diameter - Inches	Length - Feet	Slot Size - Inches
2	10	.008

Screen Type	Depth to Bottom - Feet
PVC	30

DESCRIPTION OF FORMATIONS ENCOUNTERED	FROM	TO
Sand	0	30

FORMATIONS (Continued)	FROM	TO

IF MORE SPACE IS NEEDED, USE BACK

REC'D JUN 25 2001

If well telescopes please
sketch and show depths.

GROUND LEVEL

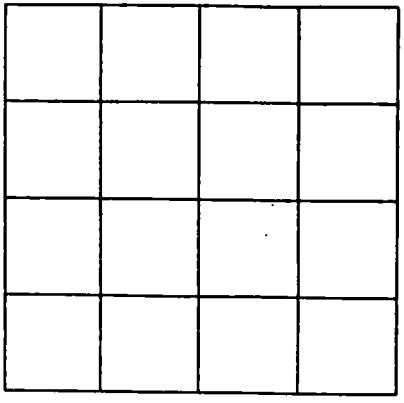

SECTION _____

Please indicate well location X.

ADDITIONAL INFORMATION

If more than one screen,
show location of each on sketch.