HINDS
K66
7-14-82

227D

MISSISSIPPI DEPARTMENT OF NATURAL RESOURCES

Bureau of Land and Water Resources
Southport Mall
P.O. Box 10631
Jackson, Mississippi 39209

WATER WELL DRILLERS LOG

7/14 — date well completed
18 — TOM GRIFFITH PLUMBING & WELL SERVICE, INC. — firm name
Hinds — county well located

LANDOWNER: Inepco Oil Co.
P.O. Box 22924
Jackson, Miss. 39205
(mailing address)

WELL LOCATION:
sec. 18 T. 5 (N) (S) R. 3 (E) (W)
12 miles (distance) S (direction) of Edwards, Miss. (nearest town)

WELL PURPOSE: Oil Test
(home, irrigation, municipal, industrial)

WELL COMPLETION DATA:

(1) diameter (inches) 3"
(2) total depth (feet) 1030
(3) static water level (feet) ~~[illegible]~~ below above top of ground. 250'
(4) casing ~~Steel~~ (material), 950 (depth),
n/a (size) if telescope see back.
(5) screen 80 (length), 950 (depth to top)
3" (size), ~~[illegible]~~ Slot (material)
(6) pump None (HP) 75 (yield gpm)
~~[illegible]~~ air lift (type power)
(7) electric log no (yes or no)
(organization running log)
(8) how well bottom plugged ~~[illegible]~~ welded

DRILLERS REMARKS:

description of formations encountered	from	to
Chalk	0	90
Rock	90	140
Shale	140	180
Rock	180	185
Chalk + Shale	185	300
Rock + Shale	300	320
Sand + Shale	780	800
Chalk	320	420
Rock	420	435
Chalk	435	519
Shale	519	560
Chalk	560	750
Chalk + Shale	750	780
Chalk	780	950
Sand	950	1030

Elevation 240

32163709032 42

DEPT. OF NATURAL RESOURCES
BUREAU OF LAND & WATER RESOURCES
AUG - 9 1982
RECEIVED

If well telescopes please sketch and show depths.

GROUND LEVEL

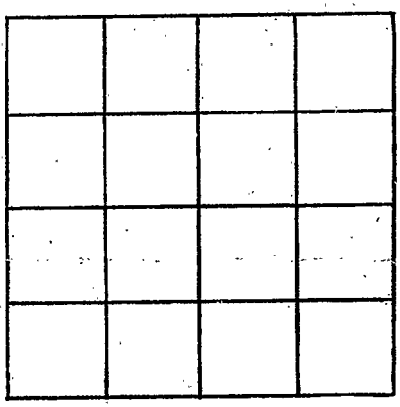

SECTION _____

Please indicate well location X.

ADDITIONAL INFORMATION

If more than one screen, show locations of each on sketch.