HINDS
L62
9/25/78
Flog # 633

MISSISSIPPI
BOARD OF WATER COMMISSIONERS
416 North State Street
Jackson, Mississippi 39201

CODED

WATER WELL DRILLERS LOG

9/25 1978 Jack Lim Water Well Dr. Hinds
date well completed — firm name — county well located

LANDOWNER Wayne Caldwell
Clinton, Ms.
(mailing address)

WELL LOCATION:
sec 1 T 5 N/S R 2 E/W
2½ (distance) miles S (direction) of Clinton (nearest town)

WELL PURPOSE: Home
(home, irrigation, municipal, industrial)

WELL COMPLETION DATA:
(1) diameter (inches) 6 in.
(2) total depth (feet) 220 ft.
(3) static water level (feet) 48 below/above top of ground.
(4) casing Steel (material), 200 ft. (depth), 6 in. (size) if telescope see back.
(5) screen 20 ft. (length), 200-220 (depth to top), 4 in. (size), Johnson S.S. (material)
(6) pump 7½ (HP) 100 gal. (yield gpm) Electric (type power)
(7) electric log yes (yes or no) M. S. G. (organization running log)
(8) how well bottom plugged back wash valve

DRILLERS REMARKS:

description of formations encountered	from	to
yellow clay	0	40
gravel	40	50
blue mud	50	170
sandy shell	170	200
water sand	200	230

CODED

RECEIVED
SEP 27 1978
MISS. BD. OF WATER COMM

If well telescopes please sketch and show depths.

GROUND LEVEL

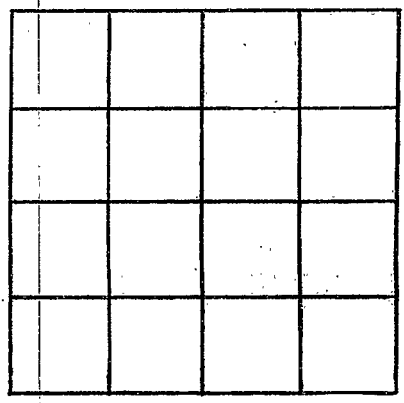

SECTION _____

Please indicate well location X.

ADDITIONAL INFORMATION

If more than one screen, show locations of each on sketch.