Issaquena
A63
1-15-81
Elvg #104

3

MISSISSIPPI
BOARD OF WATER COMMISSIONER
416 North State Street
Jackson, Mississippi 392[illegible]

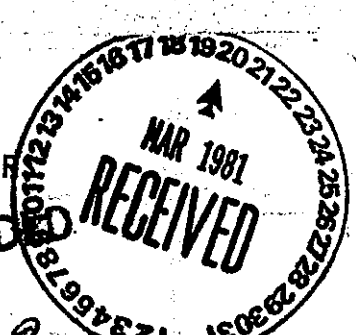

BOGUED

WATER WELL DRILLERS LOG

1/15/81 — date well completed
19 80 — Jack C Guin — firm name
Issaquena — county well located

LANDOWNER: E.L. Ramsay Estate

(mailing address)

WELL LOCATION:
sec. 30 T. 13 (N) (S) R. 8 (E) (W)
12 (distance) miles N (direction) Rolling Fork (nearest town)

WELL PURPOSE: Home (home, irrigation, municipal, industrial)

WELL COMPLETION DATA:
(1) diameter (inches) 4
(2) total depth (feet) 528
(3) static water level (feet) 18 below above top of ground.
(4) casing P.V.C. (material), 460 (depth),
4 (size) If telescope see back.
(5) screen 30 (length), 460 (depth to top)
4 (size), P.V.C. (material)
(6) pump 1 (HP) 10 (yield gpm)
Electric (type power)
(7) electric log yes (yes or no)
Mid. St. (organization running log)
(8) how well bottom plugged Backwash valve

DRILLERS REMARKS:

description of formations encountered	from	to
Sand	0	120
Shell	120	280
Sand	280	380
Clay	380	420
Sand	420	520

BOGUED

DEPT. OF NATURAL RESOURCES
BUREAU OF LAND & WATER RESOURCES
MAR 20 1981
RECEIVED