JACKSON
A 2006

10-22-80

MISSISSIPPI
BOARD OF WATER COMMISSIONERS
416 North State Street
Jackson, Mississippi 39201

WATER WELL DRILLERS LOG

10-22-80 19 Coast Water Well Serv. Inc. Jackson
date well completed — firm name — county well located

LANDOWNER: Les French
4800 Forest St.
Moss Point, Miss.
(mailing address)

WELL LOCATION:
sec. 10 T 4 ~~N~~ (S) R 9 ~~E~~ (W)
14 (distance) miles N (direction) of LATIMER (nearest town)

WELL PURPOSE: Home
(home, irrigation, municipal, industrial)

WELL COMPLETION DATA:

(1) diameter (inches) 2"
(2) total depth (feet) 90'
(3) static water level (feet) 30' below above top of ground.
(4) casing PVC (material), 80' (depth), 2" (size) If telescope see back.
(5) screen 10' (length), 80' (depth to top), 2" (size), PVC (material)
(6) pump 1 hp. (HP) 9 (yield gpm) Elect. (type power)
(7) electric log No. (yes or no) N/A. (organization running log)
(8) how well bottom plugged Back Wash Valve

DRILLERS REMARKS:

description of formations encountered	from	to
Top soil	0	3'
R. Clay	3'	25'
M.C. Sand	25'	50'
Red Clay	50'	65'
C. Sand	65'	90'

DEPT. OF NATURAL RESOURCES
BUREAU OF LAND & WATER RESOURCES
APR 6 198
RECEIVED

If well telescopes please sketch and show depths.

GROUND LEVEL

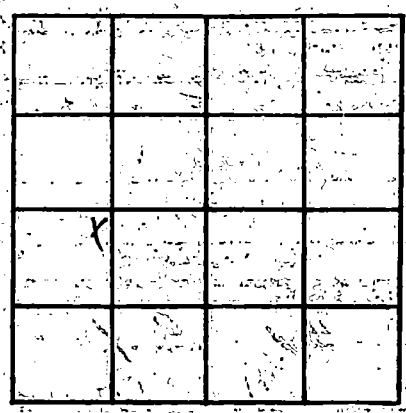

SECTION 10

Please indicate well location X.

ADDITIONAL INFORMATION

If more than one screen, show locations of each on sketch.