JACKSON
C 2006
3-14-79

MISSISSIPPI
BOARD OF WATER COMMISSIONERS
416 North State Street
Jackson, Mississippi 39201

WATER WELL DRILLERS LOG

3/14 1979 Pierce Drilling Co. Jackson
date well completed — firm name — county well located

LANDOWNER: Claude Hartley
Moselle,
Jackson Miss.
(mailing address)

WELL LOCATION:
sec. 14 T 4 N R 6 E
3 (S) NW (W) Hurley
17 miles South of Lucedale
(distance) (direction) (nearest town)

WELL PURPOSE:
(home, irrigation, municipal, industrial)

WELL COMPLETION DATA:

(1) diameter (inches) 2
(2) total depth (feet) 45
(3) static water level (feet) 30 below/above top of ground
(4) casing PLASTIC (material), 40 (depth),
0 (size) if telescope see-back.
(5) screen 5 (length), 45 (depth to top)
010 (size), PLASTIC (material)
(6) pump 1 (HP) 10 (yield gpm)
Gas (type power)
(7) electric log (yes or no)
(organization running log)
(8) how well bottom plugged BW.

DRILLERS REMARKS:

description of formations encountered	from	to
TOP SOIL	0	10
CLAY	10	20
GOOD SAND	20	45

Miss. Board of Water Comm.
MAY 31 1979
RECEIVED

If well telescopes please sketch and show depths.

GROUND LEVEL

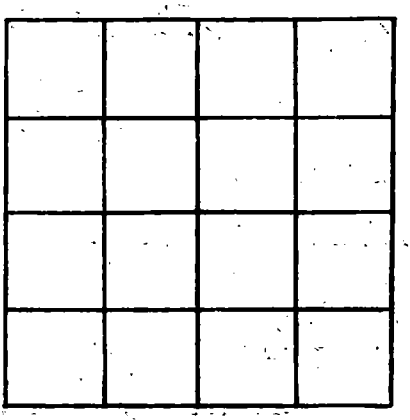

SECTION _____

Please indicate well location X.

ADDITIONAL INFORMATION

If more than one screen, show locations of each on sketch.