JACKSON
C 2008
8-8-79

MISSISSIPPI
BOARD OF WATER COMMISSIONERS
416 North State Street
Jackson, Mississippi 39201

WATER WELL DRILLERS LOG

8-8- 1979 Coast Water Well Serv. Jackson
date well completed — firm name — county well located

LANDOWNER: W. E. Goff
Rt 5 - Box 229
Pascagoula Miss.
(mailing address)

WELL LOCATION:
sec. 35 T. 4 (S) R. 6 (W)
1 miles North (direction) of Wade (nearest town)
(distance)

WELL PURPOSE: None.
(home, irrigation, municipal, industrial)

WELL COMPLETION DATA:
(1) diameter (inches) 2"
(2) total depth (feet) 363
(3) static water level (feet) 4' below above top of ground.
(4) casing PVC (material), 353' (depth), 2" (size) if telescope see back.
(5) screen 10' (length), 353' (depth to top), 2" (size), PVC (material)
(6) pump 1 h.p. (HP) 8 (yield gpm)
Elec. (type power)
(7) electric log No (yes or no)
—
(organization running log)
(8) how well bottom plugged Back Wash Valve.

DRILLERS REMARKS:

description of formations encountered	from	to
Top Soil	0	3
Red Clay	3	18
Blue Clay	18	40
White Coarse sand	40	112
Blue Clay	112	176
Blue Clay & Oyster Shell	176	299
Gray Coarse sand & gravel	299	363

DEPT. OF NATURAL RESOURCES
BUREAU OF LAND & WATER RESOURCES
FEB 26 1980
RECEIVED

If well telescopes please sketch and show depths.

GROUND LEVEL

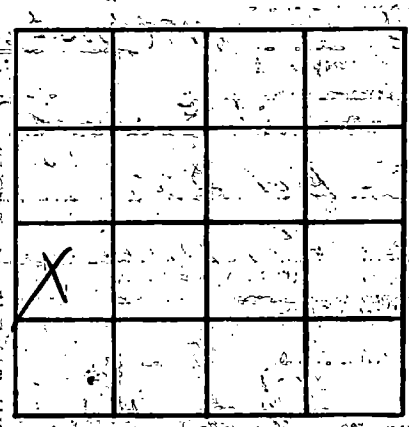

SECTION 35

Please indicate well location X.

ADDITIONAL INFORMATION

If more than one screen, show locations of each on sketch.