MISSISSIPPI DEPARTMENT OF ENVIRONMENTAL QUALITY
Office of Land and Water Resources

P. O. Box 10631
Jackson, MS 39289-0631

WATER WELL DRILLERS LOG

COUNTY WELL LOCATED: Jackson	
WELL NUMBER: C 2056	CODED:
DATE WELL COMPLETED: 7-21-97	PERMIT NUMBER:
	NAME OF DRILLING FIRM: Coastwater Well Service

NAME & MAILING ADDRESS OF LANDOWNER:
Kevin Lewelling
Sammy Hearndon Rd.
Pascagoula, Ms.

WELL LOCATION SEC	TOWNSHIP	RANGE
26	4 N (S)	6 E (W)

DISTANCE	DIRECTION	NEAREST TOWN
2 Miles	NE of	WADE

OTHER LANDMARK:

WELL PURPOSE: (Home) Irrigation, Municipal, Industrial, Fish Pond, etc

PUMP DATA

PUMP TYPE (Circle One): Submersible, Turbine, (Jet) Flowing Well, Other (Describe) _____

POWER TYPE (Circle One): (Electric) Tractor, Diesel, Gasoline, Butane, Other (Describe) _____ H/P 1

Pump Capacity (GPM)	No. of Stages	Setting Depth
10	2	FT.

PUMP TEST

Well yielded _____ GPM with a drawdown of _____ ft. after _____ hours of pumping

WELL DATA

Well Depth	Casing Diameter (In.)	Casing Length (Ft.)
68'	2"	58'

Type of Casing	Hole Depth	Depth to Static Water Level
PVC	68'	10'

TYPE OF COMPLETION: (Circle One or More): Gravel Packed, Underreamed, Telescoped, (Natural Development), Open Hole, Other (Describe) _____

WELL GROUTED TO A DEPTH OF 20 FEET
Type Grout (circle one): Cement, (Bentonite), or Mix

LOG DATA

TYPE OF LOG RUN (Circle One): (No Log Run), Electric, Gamma Ray, Density, Sonic, Neutron, Other (Describe) _____

Name of Organization Running Log

GEOLOGIC DATA (Office Use Only)

Surface Elev.	Geologic Unit	Unit Thickness	Depth to Top
Subs. SWL	Date	Analysis	Aquifer Test

Driller's Remarks

SCREEN DATA

Diameter - Inches	Length - Feet	Slot Size - Inches
2"	10'	.008

Screen Type	Depth to Bottom - Feet
PVC	68'

Top of Lap Pipe or Reduction in Casing FEET

IF TELESCOPED OR MORE THAN ONE SCREEN: USE BACK PAGE

DESCRIPTION OF FORMATIONS ENCOUNTERED	FROM	TO
Top Soil	0	2
Blue Clay	2	48
White Coarse Sand & Gravel	48	68

FORMATIONS (Continued)	FROM	TO

IF MORE SPACE IS NEEDED USE BACK

RECEIVED
AUG 27 1997
Dept. of Environmental Quality
Office of Land & Water Resources

If well telescopes please sketch and show depths.

GROUND LEVEL

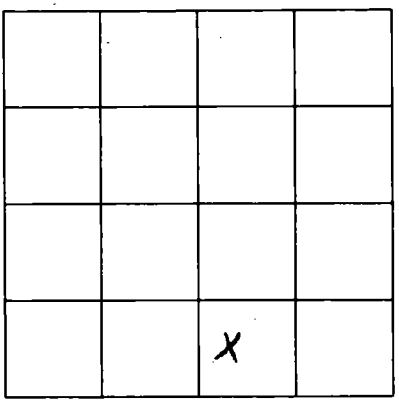

SECTION 26

Please indicate well location X.

ADDITIONAL INFORMATION

If more than one screen, show location of each on sketch.