**MISSISSIPPI DEPARTMENT OF ENVIRONMENTAL QUALITY**
Office of Land and Water Resources
P. O. Box 10631
Jackson, MS 39289-0631
**WATER WELL DRILLERS LOG**

| | |
|---|---|
| COUNTY WELL LOCATED: Jackson | PERMIT NUMBER: |
| WELL NUMBER: C2065 CODED: | NAME OF DRILLING FIRM: Southern Water Well Hurley, MS |
| DATE WELL COMPLETED: 12-3-99 | |

NAME & MAILING ADDRESS OF LANDOWNER
Zenith Dock
24923 Pelkstown
Lucedale

| WELL LOCATION | SEC | TOWNSHIP | RANGE |
|---|---|---|---|
| | 11 | 4 N (S) | 6 E (W) |

| DISTANCE | DIRECTION | NEAREST TOWN |
|---|---|---|
| Miles | of | |

OTHER LANDMARK

WELL PURPOSE: Home, Irrigation, Municipal, Industrial, Fish Pond, etc.
Home

## PUMP DATA

PUMP TYPE (Circle One): Submersible, Turbine, (Jet) Flowing Well, Other (Describe)

POWER TYPE (Circle One): (Electric) Tractor, Diesel, Gasoline, Butane, Other (Describe) H/P

| Pump Capacity (GPM) | No. of Stages | Setting Depth |
|---|---|---|
| 10 | 2 | — FT. |

PUMP TEST
Well yielded 6 GPM with a drawdown of ft. after hours of pumping

## WELL DATA

| Well Depth | Casing Diameter (In.) | Casing Length (Ft.) |
|---|---|---|
| 35' | 2" | 30' |
| **Type of Casing** | **Hole Depth** | **Depth to Static Water Level** |
| PVC | 35' | 15' |

TYPE OF COMPLETION: (Circle One or More): Gravel Packed, Underreamed, Telescoped, Natural Development, Open Hole, Other (Describe) air

**WELL GROUTED TO A DEPTH OF _____ FEET**
**Type Grout (circle one): Cement, Bentonite, or Mix**

## LOG DATA

TYPE OF LOG RUN (Circle One): (No Log Run), Electric, Gamma Ray, Density, Sonic, Neutron, Other (Describe)

Name of Organization Running Log

## GEOLOGIC DATA (Office Use Only)

| Surface Elev. | Geologic Unit | Unit Thickness | Depth to Top |
|---|---|---|---|
| Subs SWL | Date | Analysis | Aquifer Test |

Driller's Remarks

Top of Lap Pipe or Reduction in Casing
FEET — IF TELESCOPED OR MORE THAN ONE SCREEN: USE BACK PAGE

## SCREEN DATA

| Diameter - Inches | Length - Feet | Slot Size - Inches |
|---|---|---|
| 2" | 5' | #8 |
| **Screen Type** | | **Depth to Bottom - Feet** |
| PVC | | 35' |

| DESCRIPTION OF FORMATIONS ENCOUNTERED | FROM | TO | FORMATIONS (Continued) | FROM | TO |
|---|---|---|---|---|---|
| | | | | | |
| | | | | | |
| | | | IF MORE SPACE IS NEEDED USE BACK | | |

If well telescopes please
sketch and show depths.

GROUND LEVEL

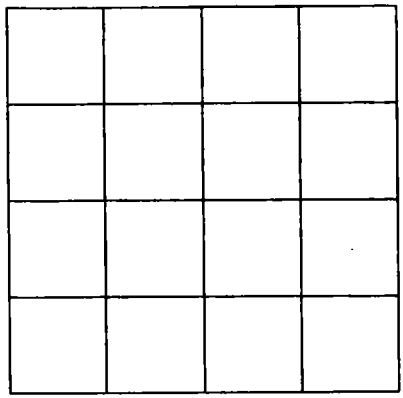

SECTION _____

Please indicate well location X.

ADDITIONAL INFORMATION

If more than one screen,
show location of each on sketch.