MISSISSIPPI DEPARTMENT OF ENVIRONMENTAL QUALITY
Office of Land and Water Resources

P. O. Box 10631
Jackson, MS 39289-0631
WATER WELL DRILLERS LOG

COUNTY WELL LOCATED: Jackson	
WELL NUMBER: C-2068	CODED:
DATE WELL COMPLETED: 4-25-00	
PERMIT NUMBER:	
NAME OF DRILLING FIRM: Pure Well	

NAME & MAILING ADDRESS OF LANDOWNER: Bob Dowdy

Hurley, Ms

WELL LOCATION — SEC: 1 TOWNSHIP: 4 N (S) RANGE: 6 E (W)

DISTANCE: 1 Miles DIRECTION: S of NEAREST TOWN: GC Line

OTHER LANDMARK:

WELL PURPOSE: (Home.) Irrigation, Municipal, Industrial, Fish Pond, etc.

PUMP DATA

PUMP TYPE (Circle One): (Submersible) Turbine, Jet Flowing Well, Other (Describe)

POWER TYPE (Circle One): (Electric) Tractor, Diesel, Gasoline, Butane, Other (Describe) H/P 3

Pump Capacity (GPM)	No. of Stages	Setting Depth
50	7	100 FT.

PUMP TEST

Well yielded 50 GPM with a drawdown of 10 ft. after 1 hours of pumping

WELL DATA

Well Depth	Casing Diameter (In.)	Casing Length (Ft.)
380'	4"	350'

Type of Casing	Hole Depth	Depth to Static Water Level
Plastic	380'	50'

TYPE OF COMPLETION: (Circle One or More): Gravel Packed, Underreamed, Telescoped, (Natural Development), Open Hole, Other (Describe)

WELL GROUTED TO A DEPTH OF 15 FEET
Type Grout (circle one): Cement, Bentonite, or (Mix)

LOG DATA

TYPE OF LOG RUN (Circle One): (No Log Run), Electric, Gamma Ray, Density, Sonic, Neutron, Other (Describe)

Name of Organization Running Log

SCREEN DATA

Diameter - Inches	Length - Feet	Slot Size - Inches
4"	30'	006

Screen Type	Depth to Bottom - Feet
Plastic	380

GEOLOGIC DATA (Office Use Only)

Surface Elev.	Geologic Unit	Unit Thickness	Depth to Top
Subs. SWL	Date	Analysis	Aquifer Test

Driller's Remarks

Top of Lap Pipe or Reduction in Casing

IF TELESCOPED OR MORE THAN ONE SCREEN USE BACK PAGE

RECEIVED
JUN 27 2000
Dept. of Environmental Quality
Office of Land & Water Resources

DESCRIPTION OF FORMATIONS ENCOUNTERED	FROM	TO
topsoil	0	10
Clay	10	20
Good Sand	20	35
Clay	35	300
good Sand	300	380

FORMATIONS (Continued)	FROM	TO

IF MORE SPACE IS NEEDED, USE BACK

If well telescopes please
sketch and show depths.

GROUND LEVEL

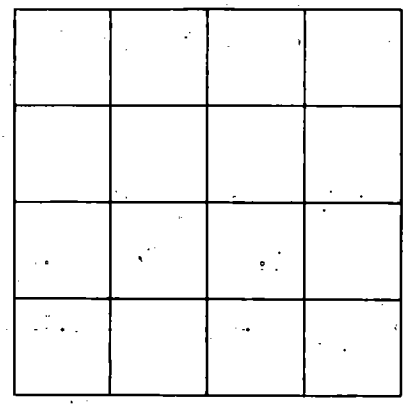

SECTION _____

Please indicate well location X.

ADDITIONAL INFORMATION

If more than one screen,
show location of each on sketch.