MISSISSIPPI DEPARTMENT OF NATURAL RESOURCES

Bureau of Land and Water Resources

P.O. Box 10631
Jackson, Mississippi 39209

WATER WELL DRILLERS LOG

COUNTY WELL LOCATED: Jackson

WELL NUMBER: D 2071 | CODED:

DATE WELL COMPLETED: 8-24-87

PERMIT NUMBER:

NAME OF DRILLING FIRM: Purci Drilling Co.

NAME & MAILING ADDRESS OF LANDOWNER:
Bonnie Redmond
Lum Reeves Rd.
Pascagoula, Ms

WELL LOCATION: SEC 28 TOWNSHIP 4 N (S) RANGE 5 E (W)

DISTANCE 1 Miles DIRECTION North of NEAREST TOWN Hurley

OTHER LANDMARK:

WELL PURPOSE: (Home) Irrigation, Municipal, Industrial, Fish Pond, etc.

PUMP DATA

PUMP TYPE (Circle One): Submersible, Turbine, (Jet) Flowing Well, Other (Describe)

POWER TYPE (Circle One): (Electric) Tractor, Diesel, Gasoline, Butane, Other (Describe)

Pump Capacity (GPM)	No. of Stages	Setting Depth
10	2	20 FT.

PUMP TEST

Well yielded 10 GPM with a drawdown of 5 ft. after 1 hours of pumping

WELL DATA

Well Depth	Casing Diameter (In.)	Casing Length (Ft.)
40'	2"	35'

Type of Casing	Hole Depth	Depth to Static Water Level
Plastic	40'	15'

TYPE OF COMPLETION: (Circle One or More): Gravel Packed, Underreamed, Telescoped, (Natural Development) Open Hole, Other (Describe)

Top of Lap Pipe or Reduction in Casing: FEET

IF TELESCOPED OR MORE THAN ONE SCREEN: USE BACK PAGE

LOG DATA

TYPE OF LOG RUN (Circle One): (No Log Run) Electric, Gamma Ray, Density, Sonic, Neutron, Other (Describe)

Name of Organization Running Log

GEOLOGIC DATA (Office Use Only)

Surface Elev.	Geologic Unit	Unit Thickness	Depth to Top
Subs. SWL	Date	Analysis	Aquifer Test

Driller's Remarks

SCREEN DATA

Diameter - Inches	Length - Feet	Slot Size - Inches
2"	5'	006

Screen Type	Depth to Bottom - Feet
Plastic	40'

DESCRIPTION OF FORMATIONS ENCOUNTERED	FROM	TO
top soil	0	10
Clay	10	20
good sand	20	40

FORMATIONS (Continued)	FROM	TO

IF MORE SPACE IS NEEDED, USE BACK

RECEIVED
SEP 15 1987
Department of Natural Resources
Bureau of Land & Water Resources

If well telescopes please
sketch and show depths.

GROUND LEVEL

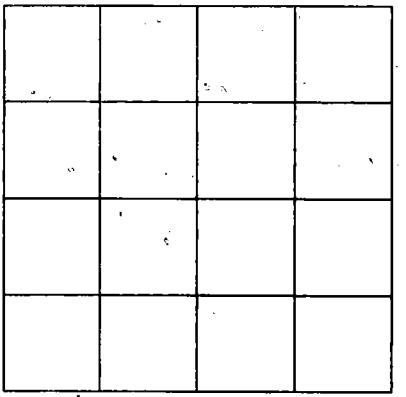

SECTION _____

Please indicate well location X.

ADDITIONAL INFORMATION

If more than one screen,
show location of each on sketch.