MISSISSIPPI DEPARTMENT OF NATURAL RESOURCES

Bureau of Land and Water Resources

P.O. Box 10631
Jackson, Mississippi 39209

WATER WELL DRILLERS LOG

COUNTY WELL LOCATED	Jackson
WELL NUMBER CODED	D2078
DATE WELL COMPLETED	4-1-88
PERMIT NUMBER	
NAME OF DRILLING FIRM	Pierce Drilling Co.

NAME & MAILING ADDRESS OF LANDOWNER
Gene Sward
7401 Carraway Rd.
Pascagoula, Ms

WELL LOCATION: SEC 28 TOWNSHIP 4 N (S) RANGE 5 E (W)

DISTANCE 1 Miles DIRECTION East of NEAREST TOWN Hurley

OTHER LANDMARK

WELL PURPOSE (Home) Irrigation, Municipal, Industrial, Fish Pond, etc.

PUMP DATA

PUMP TYPE (Circle One): Submersible, Turbine, (Jet) Flowing Well, Other (Describe) ____

POWER TYPE (Circle One): (Electric) Tractor, Diesel, Gasoline, Butane, Other (Describe) ____

Pump Capacity (GPM)	No. of Stages	Setting Depth
8	2	95' FT.

PUMP TEST

Well yielded 8 GPM with a drawdown of 5 ft. after 1 hours of pumping

WELL DATA

Well Depth	Casing Diameter (In.)	Casing Length (Ft.)
195'	2"	190'

Type of Casing	Hole Depth	Depth to Static Water Level
Plastic	195'	50'

TYPE OF COMPLETION: (Circle One or More): Gravel Packed, Underreamed, Telescoped, (Natural Development) Open Hole, Other (Describe) ____

Top of Lap Pipe or Reduction In Casing FEET

IF TELESCOPED OR MORE THAN ONE SCREEN: USE BACK PAGE

SCREEN DATA

Diameter - Inches	Length - Feet	Slot Size - Inches
2"	5'	006

Screen Type	Depth to Bottom - Feet
Plastic	195

LOG DATA

TYPE OF LOG RUN (Circle One): (No Log Run) Electric, Gamma Ray, Density, Sonic, Neutron, Other (Describe) ____

Name of Organization Running Log

GEOLOGIC DATA (Office Use Only)

Surface Elev.	Geologic Unit	Unit Thickness	Depth to Top
Subs. SWL	Date	Analysis	Aquifer Test

Driller's Remarks

RECEIVED
APR 08 1988
Department of Natural Resources
Bureau of Land & Water Resources

DESCRIPTION OF FORMATIONS ENCOUNTERED	FROM	TO
Top Soil	0	10
Clay	10	25
Good Sand	25	45
Clay	45	180
Good Sand	180	195

FORMATIONS (Continued)	FROM	TO

IF MORE SPACE IS NEEDED, USE BACK

If well telescopes please
sketch and show depths.

GROUND LEVEL

 

If more than one screen,
show location of each on sketch.

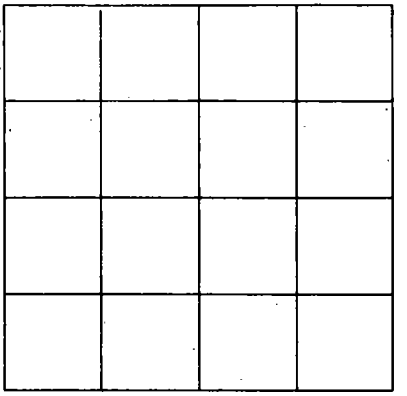

SECTION _____

Please indicate well location X.

ADDITIONAL INFORMATION