MISSISSIPPI DEPARTMENT OF ENVIRONMENTAL QUALITY
Bureau of Land and Water Resources

P. O. Box 10631
Jackson, MS 39289-0631
WATER WELL DRILLERS LOG

COUNTY WELL LOCATED	Jackson
WELL NUMBER	D2144
CODED	
DATE WELL COMPLETED	11-15-91

PERMIT NUMBER
NAME OF DRILLER: SOUTHERN WATER WELL SERVICE
Post Office Box 185
Hurley, MS 39555
Phone 588-2756

NAME & MAILING ADDRESS OF LANDOWNER
Shumack
Red Bluff Rd
Hurley MS 39555

WELL LOCATION SEC	TOWNSHIP	RANGE
26	4 N (S)	5 E (W)

DISTANCE	DIRECTION	NEAREST TOWN
20 Miles	N	of Moss Point

OTHER LANDMARK

WELL PURPOSE: Home, Irrigation, Municipal, Industrial, Fish Pond, etc.
Home

PUMP DATA

PUMP TYPE (Circle One): Submersible, Turbine, (Jet) Flowing Well, Other (Describe) _____

POWER TYPE (Circle One): (Electric) Tractor, Diesel, Gasoline, Butane, Other (Describe) _____ H/P _____

Pump Capacity (GPM)	No. of Stages	Setting Depth
12	2	FT.

PUMP TEST

Well yielded _____ GPM with a drawdown of _____ ft. after _____ hours of pumping

WELL DATA

Well Depth	Casing Diameter (In.)	Casing Length (Ft.)
65'	2"	60'
Type of Casing	**Hole Depth**	**Depth to Static Water Level**
PVC	65'	20'

TYPE OF COMPLETION: (Circle One or More): Gravel Packed, Underreamed, Telescoped, Natural Development, Open Hole, Other (Describe) an

Top of Lap Pipe or Reduction in Casing
FEET
IF TELESCOPED OR MORE THAN ONE SCREEN: USE BACK PAGE

LOG DATA

TYPE OF LOG RUN (Circle One): (No Log Run), Electric, Gamma Ray, Density, Sonic, Neutron, Other (Describe) _____

Name of Organization Running Log

GEOLOGIC DATA (Office Use Only)

Surface Elev.	Geologic Unit	Unit Thickness	Depth to Top
Subs. SWL	Date	Analysis	Aquifer Test

Driller's Remarks

SCREEN DATA

Diameter - Inches	Length - Feet	Slot Size - Inches
2"	5'	#8
Screen Type	**Depth to Bottom - Feet**	
PVC	65'	

DESCRIPTION OF FORMATIONS ENCOUNTERED	FROM	TO
Sand	0	25
Clay	25	45
Sand	45	65

FORMATIONS ENCOUNTERED	FROM	TO

IF MORE SPACE IS NEEDED, USE BACK

RECEIVED
JAN 13 1992
Dept. of Environmental Quality
Bureau of Land & Water Resources

If well telescopes please sketch and show depths.

GROUND LEVEL

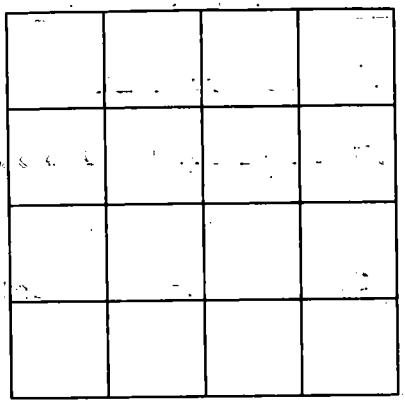

SECTION _____

Please indicate well location X.

ADDITIONAL INFORMATION

If more than one screen, show location of each on sketch.