MISSISSIPPI DEPARTMENT OF ENVIRONMENTAL QUALITY
Office of Land and Water Resources

P. O. Box 10631
Jackson, MS 39289-0631
WATER WELL DRILLERS LOG

COUNTY WELL LOCATED: Jackson	PERMIT NUMBER:
WELL NUMBER: D-23/6 — CODED	NAME OF DRILLING FIRM: Pierce Well
DATE WELL COMPLETED: 6-7-02	

NAME & MAILING ADDRESS OF LANDOWNER: Benny Lassiter
James Williams Rd. Ms
Latitude:
Longitude:

WELL LOCATION	SEC	TOWNSHIP	RANGE
	4	4 N (S)	5 E (W)

DISTANCE	DIRECTION	NEAREST TOWN
1 Miles	S of	George Co LINE

OTHER LANDMARK:

WELL PURPOSE (Home, Irrigation, Municipal, Industrial, Fish Pond, etc.): Home

WELL DATA

Well Depth	Casing Diameter (In.)	Casing Length (Ft.)
60'	2"	50'

Type of Casing	Hole Depth	Depth to Static Water Level
plastic	60'	20'

TYPE OF COMPLETION: (Circle One or More): Gravel Packed, Underreamed, Telescoped, Natural Development, Open Hole, Other (Describe)

WELL GROUTED TO A DEPTH OF 15 FEET
Type Grout (circle one): Cement, Bentonite, or Mix

SCREEN DATA

Diameter - Inches	Length - Feet	Slot Size - Inches
2"	10'	006

Screen Type	Depth to Bottom - Feet
Plastic	60'

PUMP DATA

PUMP TYPE (Circle One): Submersible, Turbine, Jet, Flowing Well, Other (Describe)

POWER TYPE (Circle One): Electric, Tractor, Diesel, Gasoline, Butane, Other (Describe) H/P 1

DESCRIPTION OF FORMATIONS ENCOUNTERED	FROM	TO
Top Soil	0	10
Clay	10	20
good sand	20	60

RECEIVED
JUN 25 2002
Dept. of Environmental Quality
Office of Land & Water Resources

Top of Lap Pipe or Reduction in Casing: 0 FEET

IF TELESCOPED OR MORE THAN ONE SCREEN: USE BACK PAGE

I certify that the well was drilled, constructed and completed in accordance with all applicable Requirements of the Mississippi Department of Environmental Quality and/or the Mississippi Department of Health regulations and state laws.

Michael Pierce 0-296
Signature of Licensed Driller and License No.

06-07-02
Date

Additional Information Required On Back

If well telescopes please sketch and show depths.

GROUND LEVEL

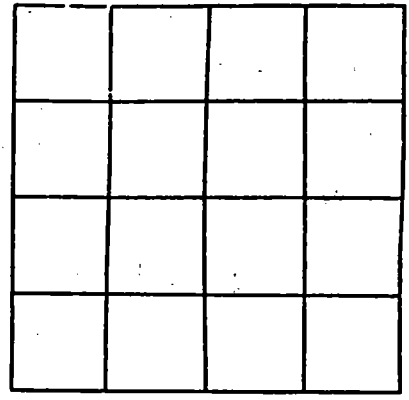

SECTION _____

Please indicate well location X.

Pump Capacity (GPM)	No. of Stages	Setting Depth
10	2	40 FT.

PUMP TEST

Well yielded 10 GPM with

a drawdown of 10 ft.

after 1 hours of pumping

LOG DATA

TYPE OF LOG RUN (Circle One): No Log Run, Electric, Gamma Ray, Density, Sonic, Neutron, Other (Describe) _____

Name of Organization Running Log

GEOLOGIC DATA (Office Use Only)

Surface Elev.	Geologic Unit	Unit Thickness	Depth to Top
Subs. SWL	Date	Analysis	Aquifer Test

Driller's Remarks

If more than one screen, show location of each on sketch.