JACKSON
F 77
6-1-74

MISSISSIPPI
BOARD OF WATER COMMISSIONERS
416 North State Street
Jackson, Mississippi 39201

CODED

WATER WELL DRILLERS LOG

June 1 19 74 Garland-Weight W/W Jackson
date well completed — firm name — county well located

LANDOWNER: Robert E. Crawford
Rt 2 Box 140
Ocean Springs Ms 39564
(mailing address)

WELL LOCATION:
sec. 35 T 5 R 7
6 miles North of Vaughan
(distance) (direction) (nearest town)

WELL PURPOSE: Home
(home, irrigation, municipal, industrial)

WELL COMPLETION DATA:

(1) diameter (inches) 2"
(2) total depth (feet) 338'
(3) static water level (feet) 78' below above top of ground
(4) casing Gal Steel 328
(material) (depth)
2" If telescope see back.
(size)
(5) screen 10' 338-328
(length) (depth to top)
2" Stainless Steel
(size) (material)
(6) pump 1 8
(HP) (yield gpm)
Electric
(type power)
(7) electric log No
(yes or no)
N/A
(organization running log)
(8) how well bottom plugged Float Ball

DRILLERS REMARKS:

description of formations encountered	from	to
Red Clay	0	17
Course White Sand	17	57
Hard White Clay	57	71
Blue Mud	71	84
Blue Clay (Hard)	84	131
Fine Sand (Blue)	131	135
Blue Mud	135	248
Fine Sand (S+P)	248	260
Blue Clay	260	310
Fine Sand (S+P)	310	315
Course Sand	315	338

CODED

JUN 1 1 1974
BD. OF WATER COMM.

If well telescopes please sketch and show depths.

GROUND LEVEL

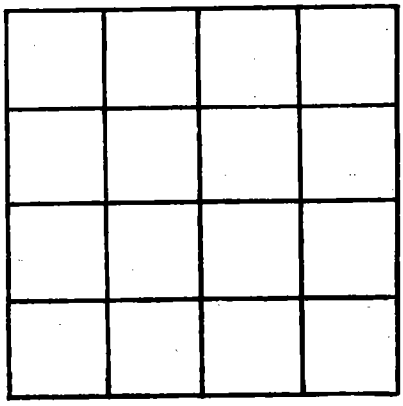

SECTION _____

Please indicate well location X.

ADDITIONAL INFORMATION

If more than one screen, show locations of each on sketch.