MISSISSIPPI DEPARTMENT OF ENVIRONMENTAL QUALITY
Bureau of Land and Water Resources

P. O. Box 10631
Jackson, MS 39289-0631

WATER WELL DRILLERS LOG

COUNTY WELL LOCATED: Jackson	
WELL NUMBER: F222D	CODED:
DATE WELL COMPLETED: 2-24-93	
PERMIT NUMBER:	
NAME OF DRILLING FIRM: Pierce	

NAME & MAILING ADDRESS OF LANDOWNER: Stephen Ates

Vancleave, MS

WELL LOCATION: SEC 26 TOWNSHIP 5 N (S) RANGE 7 E (W)

DISTANCE 3 Miles DIRECTION N of NEAREST TOWN Vancleave

OTHER LANDMARK:

WELL PURPOSE: Home, Irrigation, Municipal, Industrial, Fish Pond, etc.

PUMP DATA

PUMP TYPE (Circle One): Submersible, Turbine, (Jet) Flowing Well, Other (Describe)

POWER TYPE (Circle One): (Electric) Tractor, Diesel, Gasoline, Butane, Other (Describe) H/P 1

Pump Capacity (GPM)	No. of Stages	Setting Depth
10	2	40 FT.

PUMP TEST

Well yielded 10 GPM with a drawdown of 5 ft. after 1 hours of pumping

WELL DATA

Well Depth	Casing Diameter (In.)	Casing Length (Ft.)
65'	2"	60'

Type of Casing	Hole Depth	Depth to Static Water Level
Plastic	65'	30'

TYPE OF COMPLETION: (Circle One or More): Gravel Packed, Underreamed, Telescoped, (Natural Development), Open Hole, Other (Describe)

Top of Lap Pipe or Reduction in Casing: 0 FEET

IF TELESCOPED OR MORE THAN ONE SCREEN: USE BACK PAGE

LOG DATA

TYPE OF LOG RUN (Circle One): (No Log Run), Electric, Gamma Ray, Density, Sonic, Neutron, Other (Describe)

Name of Organization Running Log

GEOLOGIC DATA (Office Use Only)

Surface Elev.	Geologic Unit	Unit Thickness	Depth to Top
Subs. SWL	Date	Analysis	Aquifer Test

Driller's Remarks

SCREEN DATA

Diameter - Inches	Length - Feet	Slot Size - Inches
2"	5	006

Screen Type	Depth to Bottom - Feet
Plastic	65'

DESCRIPTION OF FORMATIONS ENCOUNTERED	FROM	TO	FORMATIONS (Continued)	FROM	TO
Top soil	0	10			
Clay	10	25			
Sand	25	65			
			APR 28 1993		
			Dept. of Environmental Quality		
			Office of Land & Water Resources		
			IF MORE SPACE IS NEEDED, USE BACK		

If well telescopes please sketch and show depths.

GROUND LEVEL

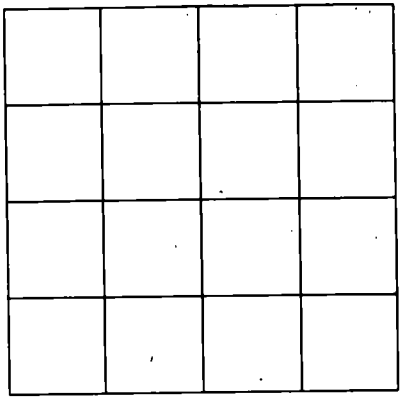

SECTION _____

Please indicate well location X.

ADDITIONAL INFORMATION

If more than one screen, show location of each on sketch.