MISSISSIPPI DEPARTMENT OF ENVIRONMENTAL QUALITY
Office of Land and Water Resources

P. O. Box 10631
Jackson, MS 39289-0631
WATER WELL DRILLERS LOG

COUNTY WELL LOCATED: Jackson	
WELL NUMBER: F2938	CODED:
DATE WELL COMPLETED: 5-20-93	
PERMIT NUMBER	
NAME OF DRILLING FIRM: Pierce Well	

NAME & MAILING ADDRESS OF LANDOWNER
Lewis Mitchell
River Rd.
Vancleave, MS

WELL LOCATION: SEC 38 TOWNSHIP 5 N (S) RANGE 7 E (W)

DISTANCE 5 Miles DIRECTION N of NEAREST TOWN Vancleave

OTHER LANDMARK

WELL PURPOSE: Home, Irrigation, Municipal, Industrial, Fish Pond, etc.

PUMP DATA

PUMP TYPE (Circle One): Submersible, Turbine, (Jet) Flowing Well, Other (Describe) _____

POWER TYPE (Circle One): (Electric,) Tractor, Diesel, Gasoline, Butane, Other (Describe) _____ H/P 1

Pump Capacity (GPM)	No. of Stages	Setting Depth
10	2	40 FT.

PUMP TEST

Well yielded 10 GPM with a drawdown of 10 ft. after 1 hours of pumping

WELL DATA

Well Depth	Casing Diameter (In.)	Casing Length (Ft.)
60	2"	55

Type of Casing	Hole Depth	Depth to Static Water Level
Plastic	60	40

TYPE OF COMPLETION: (Circle One or More): ~~Gravel Packed,~~ Underreamed, Telescoped, ~~Natural Development,~~ Open Hole, Other (Describe) _____

WELL GROUTED TO A DEPTH OF 12 FEET
Type Grout (circle one): Cement, (Bentonite,) or Mix

LOG DATA

TYPE OF LOG RUN (Circle One): (No Log Run) Electric, Gamma Ray, Density, Sonic, Neutron, Other (Describe) _____

Name of Organization Running Log

GEOLOGIC DATA (Office Use Only)

Surface Elev.	Geologic Unit	Unit Thickness	Depth to Top
Subs. SWL	Date	Analysis	Aquifer Test

Driller's Remarks

SCREEN DATA

Diameter - Inches	Length - Feet	Slot Size - Inches
2"	5'	006

Screen Type	Depth to Bottom - Feet
Plastic	60'

DESCRIPTION OF FORMATIONS ENCOUNTERED	FROM	TO
Top soil	0	10
Clay	10	20
gobed Sand	20	60

FORMATIONS (continued)	FROM	TO

IF MORE SPACE IS NEEDED, USE BACK

RECEIVED
OCT 05 1993
Dept. of Environmental Quality
Office of Land & Water Resources

If well telescopes please
sketch and show depths.

GROUND LEVEL

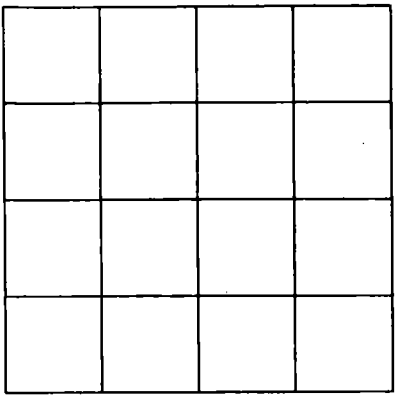

SECTION _____

Please indicate well location X.

ADDITIONAL INFORMATION

If more than one screen,
show location of each on sketch.