MISSISSIPPI DEPARTMENT OF ENVIRONMENTAL QUALITY
Office of Land and Water Resources

P. O. Box 10631
Jackson, MS 39289-0631
WATER WELL DRILLERS LOG

COUNTY WELL LOCATED: Jackson	
WELL NUMBER: F 2295	CODED
DATE WELL COMPLETED: 5-7-96	
PERMIT NUMBER	
NAME OF DRILLING FIRM: Coastwater Well Service	

NAME & MAILING ADDRESS OF LANDOWNER
Tom Watkins
Old River Rd Oaks
Vancleave, Ms

WELL LOCATION	SEC	TOWNSHIP	RANGE
	35	5 ~~N~~ (S)	7 ~~E~~ (W)

DISTANCE	DIRECTION	NEAREST TOWN
3 Miles	NE	of Vancleave

OTHER LANDMARK

WELL PURPOSE: (Home), Irrigation, Municipal, Industrial, Fish Pond, etc.

PUMP DATA

PUMP TYPE (Circle One): (Submersible), Turbine, Jet, Flowing Well, Other (Describe)

POWER TYPE (Circle One): (Electric), Tractor, Diesel, Gasoline, Butane, Other (Describe) H/P 1

Pump Capacity (GPM)	No. of Stages	Setting Depth
10	12	FT.

PUMP TEST

Well yielded _____ GPM with a drawdown of _____ ft. after _____ hours of pumping

WELL DATA

Well Depth	Casing Diameter (In.)	Casing Length (Ft.)
230'	4"	220'

Type of Casing	Hole Depth	Depth to Static Water Level
PVC	230'	125'

TYPE OF COMPLETION: (Circle One or More): Gravel Packed, Underreamed, Telescoped, (Natural Development), Open Hole, Other (Describe)

WELL GROUTED TO A DEPTH OF 20 FEET
Type Grout (circle one): Cement, (Bentonite), or Mix

LOG DATA

TYPE OF LOG RUN (Circle One): Electric, Gamma Ray, Density, Sonic, ~~Neutron~~, (No Log Run), Other (Describe)

Name of Organization Running Log

GEOLOGIC DATA (Office Use Only)

Surface Elev.	Geologic Unit	Unit Thickness	Depth to Top
Subs. SWL	Date	Analysis	Aquifer Test

Driller's Remarks

SCREEN DATA

Diameter - Inches	Length - Feet	Slot Size - Inches
4"	10'	.008

Screen Type	Depth to Bottom - Feet
PVC	230'

Top of Blank Pipe or Reduction in Casing _____ FEET

IF TELESCOPED OR MORE THAN ONE SCREEN, USE BACK PAGE

RECEIVED
JUL 15 1996
Dept. of Environmental Quality
Office of Land & Water Resources

DESCRIPTION OF FORMATIONS ENCOUNTERED	FROM	TO	FORMATIONS (Continued)	FROM	TO
Top Soil	0	2			
Red Clay	2	20			
Fine Coarse Sand	20	50			
Yellow blue gray Clay	50	165			
Fine Med Sand	165	180			
Blue Clay	180	195			
Med-Coarse Sand	195	230			
			IF MORE SPACE IS NEEDED, USE BACK		

If well telescopes please sketch and show depths.

GROUND LEVEL

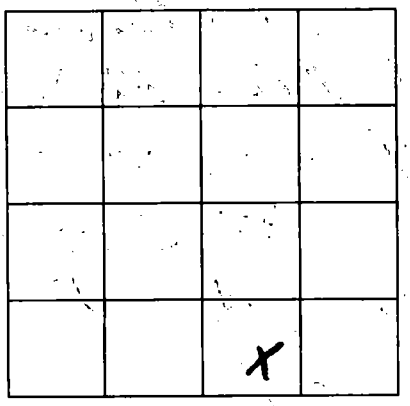

SECTION 35

Please indicate well location X.

ADDITIONAL INFORMATION

If more than one screen, show location of each on sketch.