MISSISSIPPI DEPARTMENT OF ENVIRONMENTAL QUALITY
Office of Land and Water Resources

P. O. Box 10631
Jackson, MS 39289-0631
WATER WELL DRILLERS LOG

COUNTY WELL LOCATED: Jackson	PERMIT NUMBER: 0408
WELL NUMBER: F-2423	CODED:
NAME OF DRILLING FIRM: Fryfogle Well Ser 198 Depot Rd Pucolaw MS 39482	
DATE WELL COMPLETED: 5-15-00	

NAME & MAILING ADDRESS OF LANDOWNER
Jason Hamm
2906 Washington Ave
Pascagoula MS 39567

WELL LOCATION	SEC	TOWNSHIP	RANGE
Vancleve	5	T5 S	R7 E (W)

DISTANCE	DIRECTION	NEAREST TOWN
6 Miles	north	of Vancleve

OTHER LANDMARK: Community Known as Reiser Bluff
WELL PURPOSE: Home, Irrigation, Municipal, Industrial, Fish Pond, etc.

PUMP DATA

PUMP TYPE (Circle One): Submersible, Turbine, Jet, Flowing Well, Other (Describe) _____
POWER TYPE (Circle One): Electric, Tractor, Diesel, Gasoline, Butane, Other (Describe) 10 H/P 1

Pump Capacity (GPM)	No. of Stages	Setting Depth
10	14	140 FT.

PUMP TEST
Well yielded 12 GPM with a drawdown of 2 ft. after 1 1/2 hours of pumping

WELL DATA

Well Depth	Casing Diameter (In.)	Casing Length (Ft.)
220'	4"	210

Type of Casing	Hole Depth	Depth to Static Water Level
PVC	220'	120'

TYPE OF COMPLETION: (Circle One or More): Gravel Packed, Underreamed, Telescoped, Natural Development, Open Hole, Other (Describe) air lift

WELL GROUTED TO A DEPTH OF 20 FEET
Type Grout (circle one): Cement, Bentonite, or Mix

LOG DATA

TYPE OF LOG RUN (Circle One): No Log Run, Electric, Gamma Ray, Density, Sonic, Neutron, Other (Describe) _____
Name of Organization Running Log

SCREEN DATA

Diameter - Inches	Length - Feet	Slot Size - Inches
4"	10'	#8

Screen Type	Depth to Bottom - Feet
Wrapped PVC.	220'.

GEOLOGIC DATA (Office Use Only)

Surface Elev.	Geologic Unit	Unit Thickness	Depth to Top
Subs. SWL	Date	Analysis	Aquifer Test

Driller's Remarks

Top of Lap Pipe or Reduction in Casing

RECEIVED
JUL 10 2000
Dept. of Environmental Quality
Office of Land & Water Resources

DESCRIPTION OF FORMATIONS ENCOUNTERED	FROM	TO
top Soil	0	10
Sand	10	20
Clay	20	40
"	40	60
Clay	60	140
Stiff Sand &	140	180
med Sand	180	220

FORMATIONS (Continued)	FROM	TO

IF MORE SPACE IS NEEDED, USE BACK

If well telescopes please sketch and show depths.

GROUND LEVEL

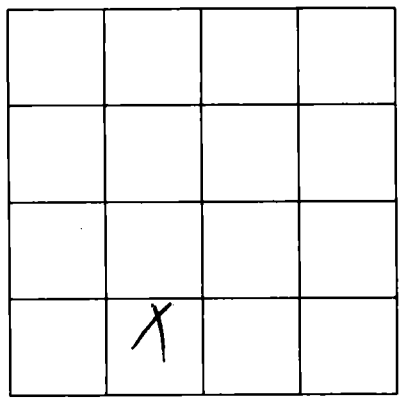

SECTION 24

Please indicate well location X.

ADDITIONAL INFORMATION

If more than one screen, show location of each on sketch.