

# JACKSON MISSISSIPPI BOARD OF WATER COMMISSIONERS

**G 27**  
**3-12-62**

## WATER WELL DRILLERS LOG

Date: 3/12, 1962, Driller: Colville County JACKSON  
50 (Name)

(1) Owner of Land Nathan Davis  
(Name)  
Wade  
(Address)

(2) Location: SW 1/4 NW 1/4, Sec. 45 T15R14W  
\_\_\_\_\_ miles \_\_\_\_\_ of \_\_\_\_\_  
(distance) (direction) (Nearest Town)  
0 CLAY 21 SAND  
32 SAND + GRAVEL 68 J.D.

(3) Topography:  (Hilly)  (Flat)  (Level)

(4) Purpose of Well: Domestic  
(Domestic Irrigation  
Municipal, Industrial, Other)

Description & Color of Materials Sand, Clay, Red Clay, Shell, etc.	Thick- ness Feet	Depth Feet

Information upon completion of well:

(1) Diameter 2 inches.

(2) Total Depth 68 feet.

(3) Water Level 36 feet below top of ground.

(4) Cased to \_\_\_\_\_, Size \_\_\_\_\_

(5) Screen: Size 2, Length 5

(6) Were any formations sealed against pollution?  
\_\_\_\_\_ yes, \_\_\_\_\_ no.

If YES depth of formation \_\_\_\_\_


Why \_\_\_\_\_

Drillers Remarks: \_\_\_\_\_

\_\_\_\_\_

\_\_\_\_\_

\_\_\_\_\_

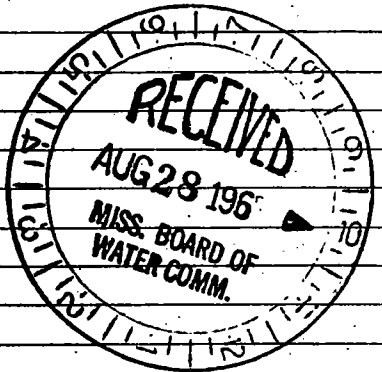

(Use Back Side)

Well No.  
114










