JACKSON
G87
2-1-72

MISSISSIPPI
BOARD OF WATER COMMISSIONERS
416 North State Street
Jackson, Mississippi 39201

CODED

WATER WELL DRILLERS LOG

Feb 1 1972 Coldwell W.S. Jackson
date well completed firm name county well located

LANDOWNER: Buddy Scarbrough
Wade Miss
(mailing address)

WELL LOCATION:
sec. 5 T N (S) R 6 E (W)
15 (distance) miles N (direction) of Moselle (nearest town)

WELL PURPOSE: home
(home, irrigation, municipal, industrial)

WELL COMPLETION DATA:

(1) diameter (inches) 2
(2) total depth (feet) 848
(3) static water level (feet) 120 below (above) top of ground.
(4) casing galv (material), 828 (depth),
~~[illegible]~~ (size) if telescope see back.
(5) screen 20' (length), 828 (depth to top)
2' (size), stainless steel (material)
(6) pump ~~[illegible]~~ (HP) 25 (yield gpm)
~~[illegible]~~ (type power)
(7) electric log no (yes or no)
(organization running log)
(8) how well bottom plugged B.P. Valve

DRILLERS REMARKS: Owner to install pump

description of formations encountered	from	to
clay	0	22
sand	22	110
clay	110	172
sand	172	120
clay	120	660
sand	660	682
clay	682	792
sand	792	848

CODED

SEP 26 1972
MISS. BD. OF WATER COMM.

If well telescopes please sketch and show depths.

GROUND LEVEL

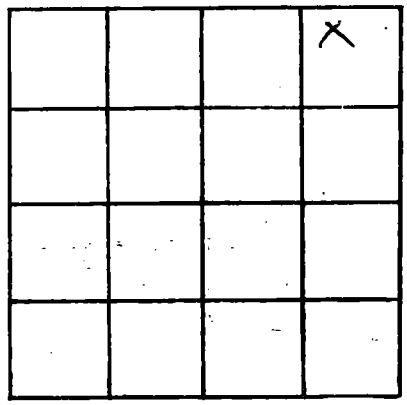

SECTION 13

Please indicate well location X.

ADDITIONAL INFORMATION

If more than one screen, show locations of each on sketch.