JACKSON
G 2017
4-29-79

MISSISSIPPI
BOARD OF WATER COMMISSIONERS
416 North State Street
Jackson, Mississippi 39201

WATER WELL DRILLERS LOG

4/29 1979 Prairie Drilling Co. Jackson
date well completed — firm name — county well located

LANDOWNER: J.D. Trelford
Ussada Miss
Jackson County Miss
(mailing address)

WELL LOCATION:
sec. 25 T 5 N R 6 E
30 miles South of Ocean Springs
(distance) (direction) (nearest town)

WELL PURPOSE: (home, irrigation, municipal, industrial)

WELL COMPLETION DATA:

(1) diameter (inches) 2"
(2) total depth (feet) 90'
(3) static water level (feet) 80 below/above top of ground
(4) casing PLASTIC 80
(material) (depth)
0 (size) if telescope see back.
(5) screen 10, 90'
(length) (depth to top)
010, PLASTIC
(size) (material)
(6) pump 1 10
(HP) (yield gpm)
Elec
(type power)
(7) electric log (yes or no)
(organization running log)
(8) how well bottom plugged BLW

DRILLERS REMARKS:

description of formations encountered	from	to
TOP SOIL	0	10
CLAY & SAND	10	35
CLAY	35	45
GOOD SAND	45	90

Miss. Board of Water Comm.
MAY 31 1979
RECEIVED

If well telescopes please sketch and show depths.

GROUND LEVEL

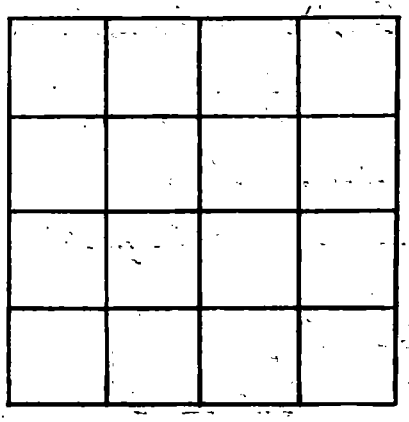

SECTION _____

Please indicate well location X.

ADDITIONAL INFORMATION

If more than one screen, show locations of each on sketch.