MISSISSIPPI DEPARTMENT OF ENVIRONMENTAL QUALITY
Bureau of Land and Water Resources

P. O. Box 10631
Jackson, MS 39289-0631
WATER WELL DRILLERS LOG

COUNTY WELL LOCATED: Jackson	
WELL NUMBER: G-2162	CODED:
	PERMIT NUMBER:
	NAME OF DRILLING FIRM: Coast Water Well Ser. Inc.
DATE WELL COMPLETED: 12-19-90	

NAME & MAILING ADDRESS OF LANDOWNER
Gwen Copeland
Hardy Parker Rd.
Pascagoula, Ms.

WELL LOCATION: SEC	TOWNSHIP	RANGE
10	5 N (S)	6 E (W)

DISTANCE	DIRECTION	NEAREST TOWN
1/2 Miles	S of	Wade

OTHER LANDMARK

WELL PURPOSE: (Home), Irrigation, Municipal, Industrial, Fish Pond, etc.

PUMP DATA

PUMP TYPE (Circle One): Submersible, Turbine, (Jet) Flowing Well, Other (Describe) _____

POWER TYPE (Circle One): (Electric) Tractor, Diesel, Gasoline, Butane, Other (Describe) _____ H/P _____

Pump Capacity (GPM)	No. of Stages	Setting Depth
18	2	FT.

PUMP TEST

Well yielded _____ GPM with

a drawdown of _____ ft.

after _____ hours of pumping

WELL DATA

Well Depth	Casing Diameter (In.)	Casing Length (Ft.)
397 402'	2"	387
Type of Casing	**Hole Depth**	**Depth to Static Water Level**
PVC	402'	91'

TYPE OF COMPLETION: (Circle One or More): Gravel Packed, Underreamed, Telescoped, (Natural Development), Open Hole, Other (Describe) _____

Top of Lap Pipe or Reduction in Casing FEET

IF TELESCOPED OR MORE THAN ONE SCREEN: USE BACK PAGE

LOG DATA

TYPE OF LOG RUN (Circle One): Electric, Gamma Ray, Density, Sonic, Neutron, Other (Describe) _____ (No Log Run)

Name of Organization Running Log

GEOLOGIC DATA (Office Use Only)

Surface Elev.	Geologic Unit	Unit Thickness	Depth to Top
Subs. SWL	Date	Analysis	Aquifer Test

Driller's Remarks

SCREEN DATA

Diameter - Inches	Length - Feet	Slot Size - Inches
2"	10'	.008
Screen Type		**Depth to Bottom - Feet**
PVC		397

DESCRIPTION OF FORMATIONS ENCOUNTERED	FROM	TO
Top soil	0	2
Yellow clay	2	25
Med. sand	25	30
Coarse sand & gravel	30	80
Blue clay streaks of sand	80	330
Coarse sand	330	402

FORMATIONS ENCOUNTERED	FROM	TO

IF MORE SPACE IS NEEDED, USE BACK

RECEIVED
JAN 11 1991
Dept. of Environmental Quality
Bureau of Land & Water Resources

If well telescopes please sketch and show depths.

GROUND LEVEL

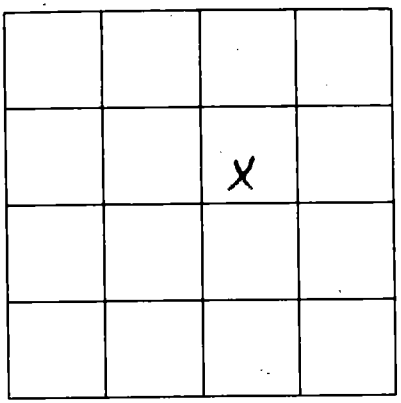

SECTION 10

Please indicate well location X.

ADDITIONAL INFORMATION

If more than one screen, show location of each on sketch.