MISSISSIPPI DEPARTMENT OF ENVIRONMENTAL QUALITY
Bureau of Land and Water Resources

P. O. Box 10631
Jackson, MS 39289-0631
WATER WELL DRILLERS LOG

COUNTY WELL LOCATED	Jackson
WELL NUMBER	G-2116
CODED	
DATE WELL COMPLETED	1/26/93
PERMIT NUMBER	
NAME OF DRILLING FIRM	SOUTHERN WATER WELL SERVICE
	Post Office Box 185
	Hurley, MS 39555
	Phone: 588-2756

NAME & MAILING ADDRESS OF LANDOWNER
Mr. Wright
Big Point Wade Rd
Pascagoula Ms

WELL LOCATION	SEC	TOWNSHIP	RANGE
	25	5 N (S)	6 E (W)

DISTANCE	DIRECTION	NEAREST TOWN
15 Miles	N	of Moss Point

OTHER LANDMARK

WELL PURPOSE: Home, Irrigation, Municipal, Industrial, Fish Pond, etc.
Fish Pond

PUMP DATA

PUMP TYPE (Circle One):
Submersible, Turbine, Jet, Flowing Well,
Other (Describe) No pump installed

POWER TYPE (Circle One):
Electric, Tractor, Diesel, Gasoline, Butane,
Other (Describe) _____ H/P _____

Pump Capacity (GPM)	No. of Stages	Setting Depth
		FT.

PUMP TEST

Well yielded N/A GPM with
a drawdown of _____ ft.
after _____ hours of pumping

WELL DATA

Well Depth	Casing Diameter (In.)	Casing Length (Ft.)
65'	2"	60'

Type of Casing	Hole Depth	Depth to Static Water Level
PVC	65'	8'

TYPE OF COMPLETION: (Circle One or More):
Gravel Packed, Underreamed, Telescoped,
Natural Development, Open Hole, Other
(Describe) air

Top of Lap Pipe or Reduction in Casing
FEET
IF TELESCOPED OR MORE THAN ONE SCREEN: USE BACK PAGE

LOG DATA

TYPE OF LOG RUN (Circle One): No Log Run,
Electric, Gamma Ray, Density, Sonic, Neutron,
Other (Describe) N/A

Name of Organization Running Log

SCREEN DATA

Diameter - Inches	Length - Feet	Slot Size - Inches
2"	5'	#8

Screen Type	Depth to Bottom - Feet
PVC	65'

GEOLOGIC DATA (Office Use Only)

Surface Elev.	Geologic Unit	Unit Thickness	Depth to Top
Subs. SWL	Date	Analysis	Aquifer Test

Driller's Remarks

DESCRIPTION OF FORMATIONS ENCOUNTERED	FROM	TO	FORMATIONS (Continued)	FROM	TO
Clay		10			
Sandy Soil	10	20			
Clay	30	45			
Sand	45	65			
			IF MORE SPACE IS NEEDED, USE BACK		

RECEIVED
FEB 23 1993
Mississippi Dept. of Environmental Quality
Office of Land & Water Resources

If well telescopes please
sketch and show depths.

GROUND LEVEL

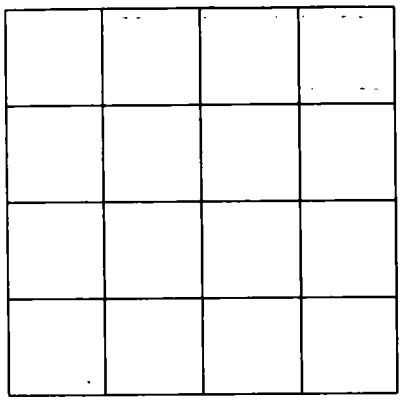

SECTION _____

Please indicate well location X.

ADDITIONAL INFORMATION

If more than one screen,
show location of each on sketch.