9

MISSISSIPPI DEPARTMENT OF ENVIRONMENTAL QUALITY
Bureau of Land and Water Resources

P. O. Box 10631
Jackson, MS 39289-0631
WATER WELL DRILLERS LOG

COUNTY WELL LOCATED: Jackson
WELL NUMBER: G 2121
DATE WELL COMPLETED: 10-1-91

PERMIT NUMBER:
NAME OF DRILLING FIRM: SOUTHERN WATER WELL SERVICE
Post Office Box 185
Hurley, MS 39555
Phone 588-2756

NAME & MAILING ADDRESS OF LANDOWNER: Diamond
Hwy 63
Wade Ms. 39555

WELL LOCATION: SEC 14 TOWNSHIP 5 N (S) RANGE 6 E (W)

DISTANCE 15 Miles DIRECTION N of NEAREST TOWN Moss Point

OTHER LANDMARK:

WELL PURPOSE: Home, Irrigation, Municipal, Industrial, Fish Pond, etc.: Home

PUMP DATA

PUMP TYPE (Circle One): Submersible, Turbine, (Jet) Flowing Well, Other (Describe)

POWER TYPE (Circle One): (Electric) Tractor, Diesel, Gasoline, Butane, Other (Describe) H/P

Pump Capacity (GPM)	No. of Stages	Setting Depth
12	1	FT.

PUMP TEST

Well yielded 8 GPM with a drawdown of ft. after hours of pumping

WELL DATA

Well Depth	Casing Diameter (In.)	Casing Length (Ft.)
60'	2"	55'

Type of Casing	Hole Depth	Depth to Static Water Level
PVC	60'	12'

TYPE OF COMPLETION: (Circle One or More): Gravel Packed, Underreamed, Telescoped, Natural Development, Open Hole, Other (Describe) air

Top of Lap Pipe or Reduction in Casing FEET

IF TELESCOPED OR MORE THAN ONE SCREEN: USE BACK PAGE

LOG DATA

TYPE OF LOG RUN (Circle One): (No Log Run), Electric, Gamma Ray, Density, Sonic, Neutron, Other (Describe)

Name of Organization Running Log

GEOLOGIC DATA (Office Use Only)

Surface Elev.	Geologic Unit	Unit Thickness	Depth to Top
Subs. SWL	Date	Analysis	Aquifer Test

Driller's Remarks

SCREEN DATA

Diameter - Inches	Length - Feet	Slot Size - Inches
2"	5'	#8

Screen Type	Depth to Bottom - Feet
PVC	60'

DESCRIPTION OF FORMATIONS ENCOUNTERED	FROM	TO
Sand	0	20
Clay	20	45
Sand	45	60

FORMATIONS (Continued)	FROM	TO

RECEIVED
JAN 13 1992
Dept. of Environmental Quality
Bureau of Land & Water Resources

IF MORE SPACE IS NEEDED, USE BACK

If well telescopes please sketch and show depths.

GROUND LEVEL

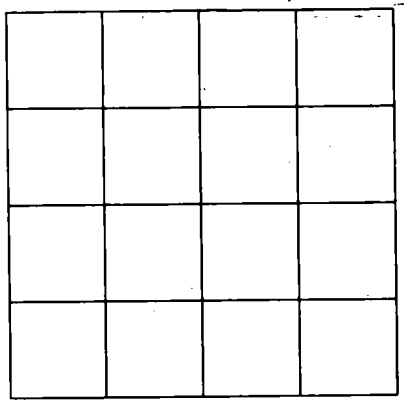

SECTION _____

Please indicate well location X.

ADDITIONAL INFORMATION

If more than one screen, show location of each on sketch.