MISSISSIPPI DEPARTMENT OF ENVIRONMENTAL QUALITY
Office of Land and Water Resources

P. O. Box 10631
Jackson, MS 39289-0631

WATER WELL DRILLERS LOG

COUNTY WELL LOCATED: Jackson	
WELL NUMBER: H2127	CODED:
PERMIT NUMBER:	
NAME OF DRILLING FIRM: Coast Water Well Service	
DATE WELL COMPLETED: 9-1-95	

NAME & MAILING ADDRESS OF LANDOWNER
Martin Young
Stateline Rd.
Hurley, Ms.

WELL LOCATION: SEC 18 TOWNSHIP 5 ~~N~~ S RANGE 5 ~~E~~ W

DISTANCE 6 Miles DIRECTION SE of NEAREST TOWN Hurley

OTHER LANDMARK

WELL PURPOSE: (Home) Irrigation, Municipal, Industrial, Fish Pond, etc.

PUMP DATA

PUMP TYPE (Circle One): Submersible, Turbine, (Jet) Flowing Well, Other (Describe)

POWER TYPE (Circle One): (Electric) Tractor, Diesel, Gasoline, Butane, ~~Other~~ (Describe) H/P 1

Pump Capacity (GPM)	No. of Stages	Setting Depth
10	2	FT.

PUMP TEST

Well yielded _____ GPM with a drawdown of _____ ft. after _____ hours of pumping

WELL DATA

Well Depth	Casing Diameter (In.)	Casing Length (Ft.)
205'	2"	195'

Type of Casing	Hole Depth	Depth to Static Water Level
PVC	205'	21'

TYPE OF COMPLETION: (Circle One or More): Gravel Packed, Underreamed, Telescoped, (Natural Development), Open Hole, Other (Describe)

WELL GROUTED TO A DEPTH OF 20 FEET
Type Grout (circle one): Cement, (Bentonite), or Mix

LOG DATA

TYPE OF LOG RUN (Circle One): (No Log Run), Electric, Gamma Ray, Density, Sonic, Neutron, Other (Describe)

Name of Organization Running Log

GEOLOGIC DATA (Office Use Only)

Surface Elev.	Geologic Unit	Unit Thickness	Depth to Top
Subs. SWL	Date	Analysis	Aquifer Test

Driller's Remarks

SCREEN DATA

Diameter - Inches	Length - Feet	Slot Size - Inches
2"	10'	.008

Screen Type	Depth to Bottom - Feet
PVC	205'

RECEIVED
OCT 13 1995
Dept. of Environmental Quality
Office of Land & Water Resources

DESCRIPTION OF FORMATIONS ENCOUNTERED	FROM	TO
Top Soil	0	2
Coarse Sand	2	40
Orange Blue Yellow Clay	40	175
Fine Med Coarse Sand	175	210

FORMATIONS (Continued)	FROM	TO

IF MORE SPACE IS NEEDED, USE BACK

If well telescopes please sketch and show depths.

GROUND LEVEL

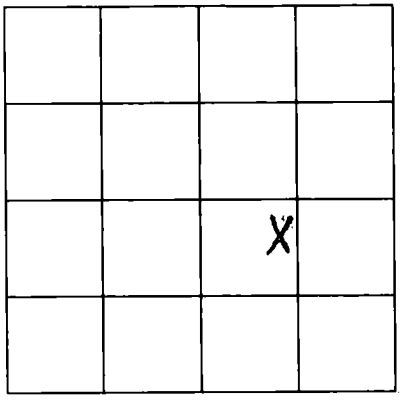

SECTION 10

Please indicate well location X.

ADDITIONAL INFORMATION

If more than one screen, show location of each on sketch.