JACKSON
J 2028
2/12/77

138

MISSISSIPPI
BOARD OF WATER COMMISSIONERS
416 North State Street
Jackson, Mississippi 39201

WATER WELL DRILLERS LOG
COAST WATER WELL SERVICE

2-12 1977 — date well completed
firm name
Jackson — county well located

LANDOWNER: Henry Nelson (Nelson)
9001 Moser Ave
Ocean Springs, Miss 39564
(mailing address)

WELL LOCATION:
sec. 23 T. 6 (S) R. 9 (W)
1½ miles S. of Latimer
(distance) (direction) (nearest town)

WELL PURPOSE: Home
(home, irrigation, municipal, industrial)

WELL COMPLETION DATA:
(1) diameter (inches) - 2 -
(2) total depth (feet) 810
(3) static water level (feet) 40 below ~~above~~ top of ground.
(4) casing PVC (material), 800 (depth),
- 2 - (size) If telescope see back.
(5) screen 10 (length), 800 (depth to top)
2 (size), PVC (material)
(6) pump 1 hp. (HP) 8½ (yield gpm)
Elect. (type power)
(7) electric log No (yes or no)
(organization running log)
(8) how well bottom plugged Packwood Value

DRILLERS REMARKS:

description of formations encountered	from	to
Top Soil	0	3
Sand (Red Coarse)	3	74
Blue Clay	74	318
Sand (Med C)	318	340
Blue Clay	340	750
Sand (Med Coarse)	750	810

RECEIVED
MAR 11 1977
MISS. BD. OF WATER COMM.

If well telescopes please sketch and show depths.

GROUND LEVEL

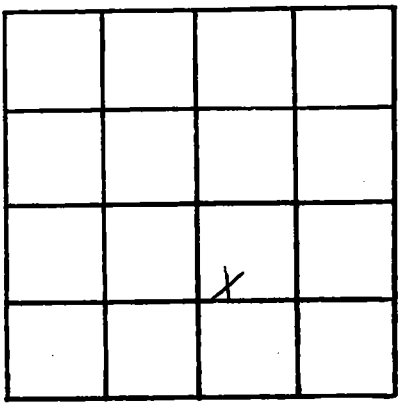

SECTION 23

Please indicate well location X.

ADDITIONAL INFORMATION

If more than one screen, show locations of each on sketch.