Jackson
32116

MISSISSIPPI DEPARTMENT OF NATURAL RESOURCES

Bureau of Land and Water Resources
Southport Mall
P.O. Box 10631
Jackson, Mississippi 39209

WATER WELL DRILLERS LOG

COASTAL DRILLING & SERVICE CO.
ROUTE 1 BOX 618
BILOXI, MISS. 39532

9/5/81 — date well completed
19 — year
Jackson — county well located

LANDOWNER: Willie Jones
Pt 5
Ocean Springs Miss
(mailing address)

WELL LOCATION:
sec 34 T 6 (N/S) R 9 (E/W)
1/2 one miles West of Exit A
(distance) (direction) (nearest town)

WELL PURPOSE: home
(home, irrigation, municipal, industrial)

WELL COMPLETION DATA:

(1) diameter (inches) 4 1/2"
(2) total depth (feet) 460'
(3) static water level (feet) 60' below ~~above~~ top of ground.
(4) casing PVC (material), 445' (depth), 4 1/2" (size) If telescope see back.
(5) screen 15' (length), 445' (depth to top), 2" (size), PVC (material)
(6) pump 1/2 one (HP) 20 gpm (yield gpm)
Ele (type power)
(7) electric log no (yes or no)
(organization running log)
(8) how well bottom plugged 2" Packer Water Valve

DRILLERS REMARKS: Sand Seal

description of formations encountered	from	to
top Soil	1	3
Red Clay	3	15
Soft Blue Clay	15	70
Sharp Sand	70	130
Soft Blue Clay	130	310
fine water Sand + Shell	310	315
hard Blue Clay	315	410
fine water Sand	410	430
good Water Sand	430	460

DEPT. OF NATURAL RESOURCES
BUREAU OF LAND & WATER RESOURCES
JAN 15 1982
RECEIVED

If well telescopes please sketch and show depths.

GROUND LEVEL

160' 4" PVC Casing

285' 2" PVC Casing

15' 2" PVC

2" backwash valve
Sand Seal

If more than one screen, show locations of each on sketch.

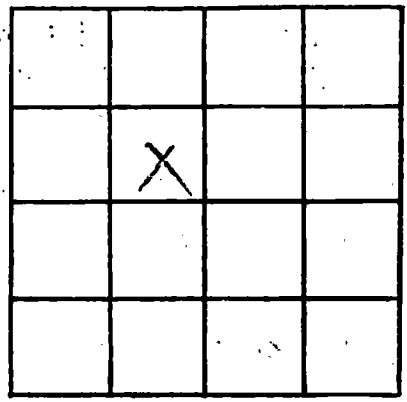

SECTION _____

Please indicate well location X.

ADDITIONAL INFORMATION