MISSISSIPPI DEPARTMENT OF NATURAL RESOURCES

Bureau of Land and Water Resources

P.O. Box 10631
Jackson, Mississippi 39209
WATER WELL DRILLERS LOG

COUNTY WELL LOCATED	Jackson
WELL NUMBER	J 2281
CODED	
DATE WELL COMPLETED	1-8-90
PERMIT NUMBER	
NAME OF DRILLING FIRM	Coast Water Well Ser. Inc.

NAME & MAILING ADDRESS OF LANDOWNER
Elwood Walker
Larue Rd
N. Biloxi, Mo. 39531

WELL LOCATION: SEC 14 TOWNSHIP 6 ~~N~~ S RANGE 9 ~~E~~ W

DISTANCE 1 Miles DIRECTION E of NEAREST TOWN LATIMER

OTHER LANDMARK

WELL PURPOSE: (Home) Irrigation, Municipal, Industrial, Fish Pond, etc.

PUMP DATA

PUMP TYPE (Circle One): Submersible, Turbine, (Jet) Flowing Well, Other (Describe) _____

POWER TYPE (Circle One): (Electric) Tractor, Diesel, Gasoline, Butane, Other (Describe) _____ H/P _____

Pump Capacity (GPM)	No. of Stages	Setting Depth
7	2	— FT.

PUMP TEST

Well yielded _____ GPM with a drawdown of _____ ft. after _____ hours of pumping

WELL DATA

Well Depth	Casing Diameter (In.)	Casing Length (Ft.)
280' 275	2"	265'

Type of Casing	Hole Depth	Depth to Static Water Level
PVC	280'	69'

TYPE OF COMPLETION: (Circle One or More): Gravel Packed, Underreamed, Telescoped, (Natural Development), Open Hole, Other (Describe) _____

Top of Lap Pipe or Reduction in Casing FEET

IF TELESCOPED OR MORE THAN ONE SCREEN: USE BACK PAGE

LOG DATA

TYPE OF LOG RUN (Circle One): (No Log Run) Electric, Gamma Ray, Density, Sonic, Neutron, Other (Describe) _____

Name of Organization Running Log

GEOLOGIC DATA (Office Use Only)

Surface Elev.	Geologic Unit	Unit Thickness	Depth to Top
Subs. SWL	Gal.	Aquifer	Aquifer Dept

Driller's Remarks

RECEIVED
MAR 30 1990
Department of Natural Resources
Bureau of Land & Water Resources

SCREEN DATA

Diameter - Inches	Length - Feet	Slot Size - Inches
2"	10'	.008

Screen Type	Depth to Bottom - Feet
PVC	275

DESCRIPTION OF FORMATIONS ENCOUNTERED	FROM	TO	FORMATIONS (Continued)	FROM	TO
Red Clay	0	12			
White Clay	12	18			
Blue Clay	18	172			
Blue Clay (Stress Zone)	172	195			
Blue Clay	195	259			
Gray Med. Sand	259	275			
Blue Clay	275	280			
			IF MORE SPACE IS NEEDED, USE BACK		

If well telescopes please
sketch and show depths.

GROUND LEVEL

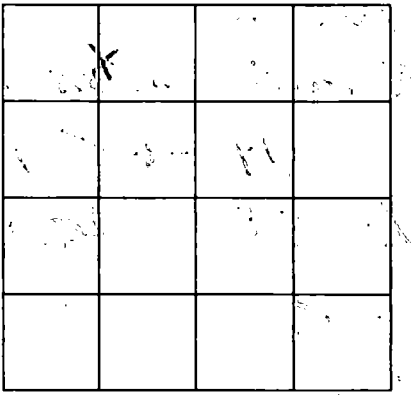

Sec. 14
SECTION

Please indicate well location X.

ADDITIONAL INFORMATION

If more than one screen,
show location of each on sketch.