MISSISSIPPI DEPARTMENT OF NATURAL RESOURCES

Bureau of Land and Water Resources

P.O. Box 10631
Jackson, Mississippi 39209
WATER WELL DRILLERS LOG

COUNTY WELL LOCATED: Jackson	
WELL NUMBER: 2989	CODED
DATE WELL COMPLETED: 9-4-90	
PERMIT NUMBER	
NAME OF DRILLING FIRM: Coast Water Well Dr. Inc.	

NAME & MAILING ADDRESS OF LANDOWNER
Rebecca McCardle
Jordon Rd
Ocean Springs, Ms

WELL LOCATION: SEC 19 TOWNSHIP 6 N/S RANGE 8 E/W

DISTANCE 6 Miles DIRECTION N of NEAREST TOWN Ocean Springs

OTHER LANDMARK

WELL PURPOSE: Home, Irrigation, Municipal, Industrial, Fish Pond, etc.

PUMP DATA

PUMP TYPE (Circle One): Submersible, Turbine, Jet, Flowing Well, Other (Describe)

POWER TYPE (Circle One): Electric, Tractor, Diesel, Gasoline, Butane, Other (Describe) H/P 1

Pump Capacity (GPM)	No. of Stages	Setting Depth
9½	2	FT.

PUMP TEST

Well yielded _____ GPM with a drawdown of _____ ft. after _____ hours of pumping

WELL DATA

Well Depth	Casing Diameter (In.)	Casing Length (Ft.)
399'	2"	382'
Type of Casing	**Hole Depth**	**Depth to Static Water Level**
PVC	397'	45'

TYPE OF COMPLETION: (Circle One or More): Gravel Packed, Underreamed, Telescoped, Natural Development, Open Hole, Other (Describe)

Top of Lap Pipe or Reduction in Casing FEET

IF TELESCOPED OR MORE THAN ONE SCREEN: USE BACK PAGE

LOG DATA

TYPE OF LOG RUN (Circle One): Electric, Gamma Ray, Density, Sonic, Neutron, Other (Describe) No Log Run

Name of Organization Running Log

GEOLOGIC DATA (Office Use Only)

Surface Elev.	Geologic Unit	Unit Thickness	Depth to Top
Subs. SWL	Date	Analysis	Aquifer Test

Driller's Remarks

SCREEN DATA

Diameter - Inches	Length - Feet	Slot Size - Inches
2"	10'	.008
Screen Type	**Depth to Bottom - Feet**	
PVC	392'	

DESCRIPTION OF FORMATIONS ENCOUNTERED	FROM	TO
Top soil	0	2
Yellow Clay	2	14
Fine sand	14	20
Blue Clay/sand	20	360
Coarse sand	360	397

FORMATIONS (Continued)	FROM	TO

RECEIVED OCT 15 1990 Department of Natural Resources Bureau of Land & Water Resources

IF MORE SPACE IS NEEDED, USE BACK

If well telescopes please
sketch and show depths.

GROUND LEVEL

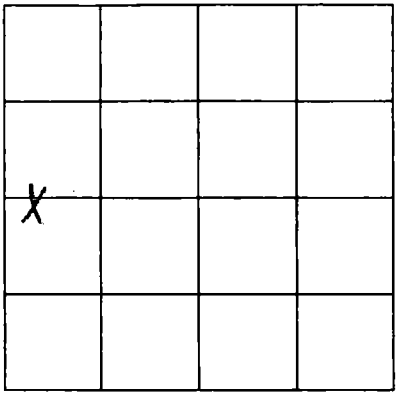

SECTION 19

Please indicate well location X.

ADDITIONAL INFORMATION

If more than one screen,
show location of each on sketch.