MISSISSIPPI DEPARTMENT OF ENVIRONMENTAL QUALITY
Bureau of Land and Water Resources

P. O. Box 10631
Jackson, MS 39289-0631
WATER WELL DRILLERS LOG

COUNTY WELL LOCATED: Jackson	PERMIT NUMBER
WELL NUMBER: 0-J-8306 CODED	NAME OF DRILLING FIRM: [illegible]
DATE WELL COMPLETED: 12-7-91	

NAME & MAILING ADDRESS OF LANDOWNER
[illegible] McDonald
[illegible] Rd.
Vancleave Ms.

WELL LOCATION: SEC 11 TOWNSHIP 6 N/S RANGE 8 E/W

DISTANCE 5 Miles **DIRECTION** W of **NEAREST TOWN** Vancleave

OTHER LANDMARK

WELL PURPOSE: Home, Irrigation, Municipal, Industrial, Fish Pond, etc.

PUMP DATA

PUMP TYPE (Circle One): Submersible, Turbine, Jet, Flowing Well, Other (Describe) _____

POWER TYPE (Circle One): Electric, Tractor, Diesel, Gasoline, Butane, Other (Describe) _____ H/P _____

Pump Capacity (GPM)	No. of Stages	Setting Depth
6	1	FT.

PUMP TEST

Well yielded _____ GPM with a drawdown of _____ ft. after _____ hours of pumping

WELL DATA

Well Depth	Casing Diameter (In.)	Casing Length (Ft.)
[illegible]	24	[illegible]

Type of Casing	Hole Depth	Depth to Static Water Level
[illegible]	[illegible]	[illegible]

TYPE OF COMPLETION: (Circle One or More): Gravel Packed, Underreamed, Telescoped, Natural Development, Open Hole, Other (Describe) _____

Top of Lap Pipe or Reduction in Casing FEET

IF TELESCOPED OR MORE THAN ONE SCREEN: USE BACK PAGE

LOG DATA

TYPE OF LOG RUN (Circle One): No Log Run, Electric, Gamma Ray, Density, Sonic, Neutron, Other (Describe) _____

Name of Organization Running Log

GEOLOGIC DATA (Office Use Only)

Surface Elev.	Geologic Unit	Unit Thickness	Depth to Top
Subs. SWL	[illegible]	[illegible]	Test

Driller's Remarks

RECEIVED
JAN 06 1992
Dept. of Environmental Quality
Bureau of Land & Water Resources

SCREEN DATA

Diameter - Inches	Length - Feet	Slot Size - Inches
2"	100'	.014

Screen Type	Depth to Bottom - Feet
PVC	100'

DESCRIPTION OF FORMATIONS ENCOUNTERED	FROM	TO	FORMATIONS (Continued)	FROM	TO
Topsoil	0	4			
[illegible]	4	12			
[illegible]	12	[illegible]			
[illegible]	[illegible]	[illegible]			
[illegible]	29	[illegible]			
			IF MORE SPACE IS NEEDED, USE BACK		

If well telescopes please sketch and show depths.

GROUND LEVEL

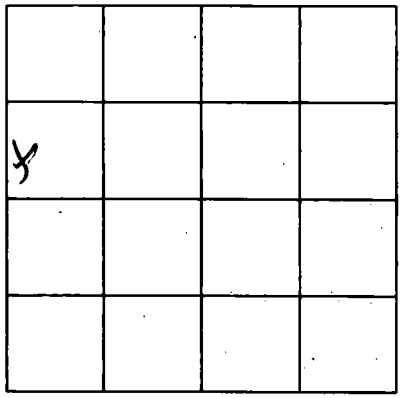

SECTION 11

Please indicate well location X.

ADDITIONAL INFORMATION

RECEIVED
Dept. of Environmental Quality
Bureau of Land & Water Resources

If more than one screen, show location of each on sketch.