MISSISSIPPI DEPARTMENT OF ENVIRONMENTAL QUALITY
Office of Land and Water Resources

P. O. Box 10631
Jackson, MS 39289-0631
WATER WELL DRILLERS LOG

COUNTY WELL LOCATED: Jackson
WELL NUMBER: J 2371 CODED
DATE WELL COMPLETED: 9-29-93

PERMIT NUMBER:
NAME OF DRILLING FIRM: Coast Water Wells Inc

NAME & MAILING ADDRESS OF LANDOWNER: George Hopkins Wright Homes
Broadway Rd.
Ocean Springs Ms

WELL LOCATION: SEC 26 TOWNSHIP 6 S RANGE 9 E (W)

DISTANCE 6 Miles DIRECTION NW of NEAREST TOWN Ocean Springs

OTHER LANDMARK:

WELL PURPOSE: Home, Irrigation, Municipal, Industrial, Fish Pond, etc.

PUMP DATA

PUMP TYPE (Circle One): Submersible, Turbine, Jet, Flowing Well, Other (Describe)

POWER TYPE (Circle One): Electric, Tractor, Diesel, Gasoline, Butane, Other (Describe) H/P 1

Pump Capacity (GPM)	No. of Stages	Setting Depth
6	2	FT.

PUMP TEST

Well yielded _____ GPM with a drawdown of _____ ft. after _____ hours of pumping

WELL DATA

Well Depth	Casing Diameter (In.)	Casing Length (Ft.)
365'	2"	351'
Type of Casing	**Hole Depth**	**Depth to Static Water Level**
PVC	365'	80'

TYPE OF COMPLETION: (Circle One or More): Gravel Packed, Underreamed, Telescoped, Natural Development, Open Hole, Other (Describe)

WELL GROUTED TO A DEPTH OF 26 FEET
Type Grout (circle one): Cement, Bentonite, or Mix

SCREEN DATA

Diameter - Inches	Length - Feet	Slot Size - Inches
2"	10'	.004
Screen Type		**Depth to Bottom - Feet**
PVC		361

LOG DATA

TYPE OF LOG RUN (Circle One): No Log Run, Electric, Gamma Ray, Density, Sonic, Neutron, Other (Describe)

Name of Organization Running Log

GEOLOGIC DATA (Office Use Only)

Surface Elev.	Geologic Unit	Unit Thickness	Depth to Top
Subs. SWL	Date	Chem. Analysis	Aquifer Test

Driller's Remarks

RECEIVED
OCT 08 1993
Dept. of Environmental Quality
Office of Land & Water Resources

DESCRIPTION OF FORMATIONS ENCOUNTERED	FROM	TO	FORMATIONS (Continued)	FROM	TO
Top soil	0	2			
Yellow clay	2	20			
Blue Clay & sand	20	215			
fine sand	215	230			
Blue Clay	230	290			
Med. sand	290	360			
Blue Clay	360	365			
			IF MORE SPACE IS NEEDED, USE BACK		

If well telescopes please sketch and show depths.

GROUND LEVEL

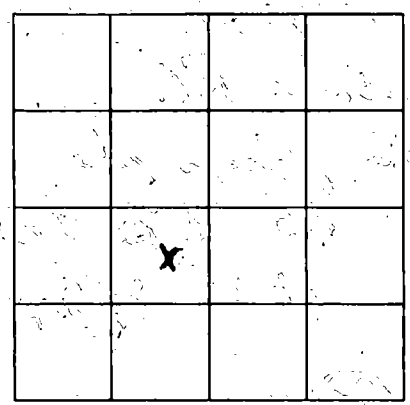

SECTION 26

Please indicate well location X.

ADDITIONAL INFORMATION

If more than one screen, show location of each on sketch.