MISSISSIPPI DEPARTMENT OF ENVIRONMENTAL QUALITY
Office of Land and Water Resources

P. O. Box 10631
Jackson, MS 39289-0631

WATER WELL DRILLERS LOG

COUNTY WELL LOCATED: Jackson	PERMIT NUMBER:
WELL NUMBER: J 2453 CODED	NAME OF DRILLING FIRM: Coast Water Well Service
DATE WELL COMPLETED: 9-1-95	

NAME & MAILING ADDRESS OF LANDOWNER: Robert Lucas H-5 Meadowglen Rd Vancleave, Ms

WELL LOCATION: SEC 10 TOWNSHIP 6 N/S RANGE 8 E/W

DISTANCE 4 1/2 Miles DIRECTION West of NEAREST TOWN Vancleave

OTHER LANDMARK:

WELL PURPOSE: Home, Irrigation, Municipal, Industrial, Fish Pond, etc.

PUMP DATA

PUMP TYPE (Circle One): Submersible, Turbine, Jet, Flowing Well, Other (Describe) _____

POWER TYPE (Circle One): Electric, Tractor, Diesel, Gasoline, Butane, Other (Describe) _____ H/P _____

Pump Capacity (GPM)	No. of Stages	Setting Depth
10	2	FT.

PUMP TEST

Well yielded _____ GPM with a drawdown of _____ ft. after _____ hours of pumping

WELL DATA

Well Depth	Casing Diameter (In.)	Casing Length (Ft.)
65'	2"	55'
Type of Casing	**Hole Depth**	**Depth to Static Water Level**
PVC	65'	20

TYPE OF COMPLETION: (Circle One or More): Gravel Packed, Underreamed, Telescoped, Natural Development, Open Hole, Other (Describe) _____

WELL GROUTED TO A DEPTH OF 20 FEET
Type Grout (circle one): Cement, Bentonite, or Mix

LOG DATA

TYPE OF LOG RUN (Circle One): No Log Run, Electric, Gamma Ray, Density, Sonic, Neutron, Other (Describe) _____

Name of Organization Running Log

GEOLOGIC DATA (Office Use Only)

Surface Elev.	Geologic Unit	Unit Thickness	Depth to Top
Subs. SWL	Date	Analysis	Aquifer Test

Driller's Remarks

RECEIVED
OCT 13 1995
Dept. of Environmental Quality
Office of Land & Water Resources

SCREEN DATA

Diameter - Inches	Length - Feet	Slot Size - Inches
2"	10'	.004
Screen Type		**Depth to Bottom - Feet**
PVC wrapped		65'

DESCRIPTION OF FORMATIONS ENCOUNTERED	FROM	TO	FORMATIONS (Continued)	FROM	TO
Top Soil	0	2			
Yellow grey clay	2	20			
Fine-Mud sand	20	35			
Blue Clay	35	40			
Med Sand	40	65			
			IF MORE SPACE IS NEEDED, USE BACK		

If well telescopes please sketch and show depths.

GROUND LEVEL

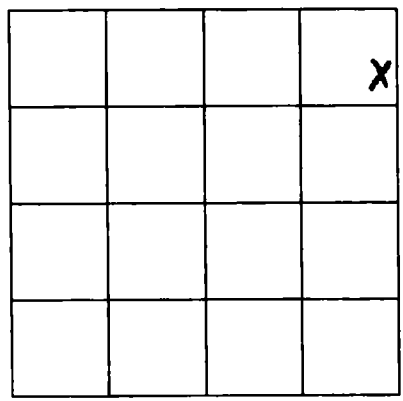

SECTION 10

Please indicate well location X.

ADDITIONAL INFORMATION

If more than one screen, show location of each on sketch.