MISSISSIPPI DEPARTMENT OF ENVIRONMENTAL QUALITY
Office of Land and Water Resources

P. O. Box 10631
Jackson, MS 39289-0631

WATER WELL DRILLERS LOG

COUNTY WELL LOCATED: Jackson	PERMIT NUMBER:
WELL NUMBER: J 2445 / CODED:	NAME OF DRILLING FIRM: Coast Water Well Service
DATE WELL COMPLETED: 12-14-95	

NAME & MAILING ADDRESS OF LANDOWNER:
William Watson
Tucker Rd.
Ocean Springs Ms

WELL LOCATION: SEC. 26 TOWNSHIP 6 N (S) RANGE 9 E (W)

DISTANCE: 5 1/2 Miles DIRECTION: N of NEAREST TOWN: Ocean Springs

OTHER LANDMARK:

WELL PURPOSE: Home, Irrigation, Municipal, Industrial, Fish Pond, etc.

PUMP DATA

PUMP TYPE (Circle One): Submersible, Turbine, Jet, Flowing Well, Other (Describe) _____

POWER TYPE (Circle One): Electric, Tractor, Diesel, Gasoline, Butane, Other (Describe) _____ H/P 2

Pump Capacity (GPM)	No. of Stages	Setting Depth
10		FT.

PUMP TEST

Well yielded _____ GPM with a drawdown of _____ ft. after _____ hours of pumping

WELL DATA

Well Depth	Casing Diameter (In.)	Casing Length (Ft.)
410'	2"	400'
Type of Casing	**Hole Depth**	**Depth to Static Water Level**
PVC	410'	85'

TYPE OF COMPLETION: (Circle One or More): Gravel Packed, Underreamed, Telescoped, Natural Development, Open Hole, Other (Describe) _____

WELL GROUTED TO A DEPTH OF 20 FEET
Type Grout (circle one): Cement, Bentonite, or Mix

SCREEN DATA

Diameter - Inches	Length - Feet	Slot Size - Inches
2"	10'	.004
Screen Type		**Depth to Bottom - Feet**
PVC wrapped		410'

LOG DATA

TYPE OF LOG RUN (Circle One): No Log Run, Electric, Gamma Ray, Density, Sonic, Neutron, Other (Describe) _____

Name of Organization Running Log

GEOLOGIC DATA (Office Use Only)

Surface Elev.	Geologic Unit	Unit Thickness	Depth to Top
Subs. SWL	Date	Analysis	Aquifer Test

Driller's Remarks

DESCRIPTION OF FORMATIONS ENCOUNTERED	FROM	TO	FORMATIONS (Continued)	FROM	TO
Top Soil	0	2			
grey blue clay streaks sand	2	150			
Fine sand	150	173			
Blue Clay streaks sand	173	295			
Coarse sand	295	308			
Blue Clay streaks sand	308	386			
Medium sand	386	410			
			IF MORE SPACE IS NEEDED, USE BACK		

JAN 29 1996
Dept. of Environmental Quality
Office of Land & Water Resources

If well telescopes please sketch and show depths.

GROUND LEVEL

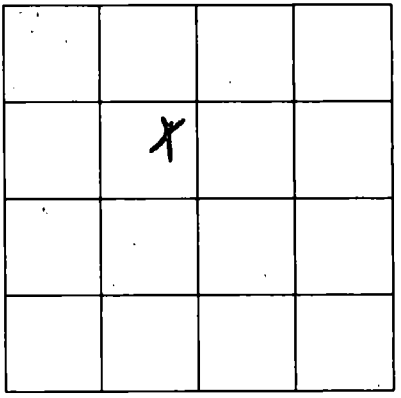

SECTION 26

Please indicate well location X.

ADDITIONAL INFORMATION

If more than one screen, show location of each on sketch.