MISSISSIPPI DEPARTMENT OF ENVIRONMENTAL QUALITY
Office of Land and Water Resources

P. O. Box 10631
Jackson, MS 39289-0631

WATER WELL DRILLERS LOG

COUNTY WELL LOCATED: Jackson
WELL NUMBER: J 2579 CODED
DATE WELL COMPLETED: 8-21-96
PERMIT NUMBER:
NAME OF DRILLING FIRM: Coast Water Well Service

NAME & MAILING ADDRESS OF LANDOWNER: Robert Lucas X-16 Schoolland Rd. Vancleave, Ms

WELL LOCATION: SEC 9 TOWNSHIP 6 (N/S) RANGE 8 (E/W)

DISTANCE: 6 Miles DIRECTION: West NEAREST TOWN: Vancleave

OTHER LANDMARK:

WELL PURPOSE: Home, Irrigation, Municipal, Industrial, Fish Pond, etc.

PUMP DATA

PUMP TYPE (Circle One): Submersible, Turbine, Jet, Flowing Well, Other (Describe) _____

POWER TYPE (Circle One): Electric, Tractor, Diesel, Gasoline, Butane, Other (Describe) _____ H/P _____

Pump Capacity (GPM)	No. of Stages	Setting Depth
11	2	FT.

PUMP TEST

Well yielded _____ GPM with a drawdown of _____ ft. after _____ hours of pumping

WELL DATA

Well Depth	Casing Diameter (In.)	Casing Length (Ft.)
110'	2"	100'

Type of Casing	Hole Depth	Depth to Static Water Level
PVC	110'	30'

TYPE OF COMPLETION: (Circle One or More): Gravel Packed, Underreamed, Telescoped, Natural Development, Open Hole, Other (Describe) _____

WELL GROUTED TO A DEPTH OF 20 FEET
Type Grout (circle one): Cement, Bentonite, or Mix

LOG DATA

TYPE OF LOG RUN (Circle One): No Log Run, Electric, Gamma Ray, Density, Sonic, Neutron, Other (Describe) _____

Name of Organization Running Log:

GEOLOGIC DATA (Office Use Only)

Surface Elev.	Geologic Unit	Unit Thickness	Depth to Top
Subs. SWL	Date	Analysis	Aquifer Test

Driller's Remarks:

SCREEN DATA

Diameter - Inches	Length - Feet	Slot Size - Inches
2"	10'	.004

Screen Type	Depth to Bottom - Feet
PVC Wrapped	110'

Top of Lap Pipe or Reduction in Casing: FEET

IF TELESCOPED OR MORE THAN ONE SCREEN: USE BACK PAGE

DESCRIPTION OF FORMATIONS ENCOUNTERED	FROM	TO
Top Soil	0	2
Blue Clay	2	41
White Coarse Sand	41	62
Blue Clay	62	88
Med gray sand	88	110

FORMATIONS (Continued)	FROM	TO

RECEIVED
SEP 10 1996
Dept. of Environmental Quality
Office of Land & Water Resources

IF MORE SPACE IS NEEDED, USE BACK

If well telescopes please sketch and show depths.

GROUND LEVEL

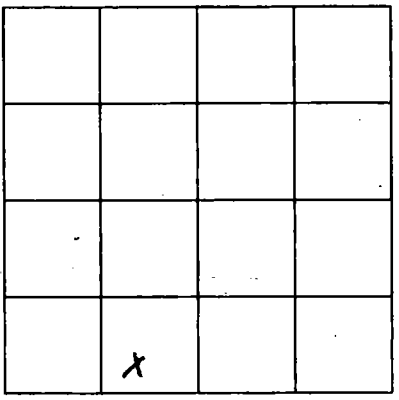

SECTION 9

Please indicate well location X.

ADDITIONAL INFORMATION

If more than one screen, show location of each on sketch.