MISSISSIPPI DEPARTMENT OF ENVIRONMENTAL QUALITY
Office of Land and Water Resources

P. O. Box 10631
Jackson, MS 39289-0631
WATER WELL DRILLERS LOG

COUNTY WELL LOCATED: Jackson	
WELL NUMBER: J 2605	CODED
DATE WELL COMPLETED: 4-16-97	PERMIT NUMBER
	NAME OF DRILLING FIRM: Coast Water Well Service

NAME & MAILING ADDRESS OF LANDOWNER
Robert Lucas G1-B
Jim Ramsey Rd.
Vancleave, Ms

WELL LOCATION	SEC	TOWNSHIP	RANGE
	10	6 (N)	8 (E)

DISTANCE	DIRECTION	NEAREST TOWN
6 Miles	West of	Vancleave

OTHER LANDMARK

WELL PURPOSE: (Home), Irrigation, Municipal, Industrial, Fish Pond, etc.

PUMP DATA

PUMP TYPE (Circle One): Submersible, Turbine, (Jet), Flowing Well, Other (Describe)

POWER TYPE (Circle One): (Electric), Tractor, Diesel, Gasoline, Butane, Other (Describe) H/P 1

Pump Capacity (GPM)	No. of Stages	Setting Depth
9	2	FT.

PUMP TEST

Well yielded _____ GPM with a drawdown of _____ ft. after _____ hours of pumping

WELL DATA

Well Depth	Casing Diameter (In.)	Casing Length (Ft.)
65'	2"	55'

Type of Casing	Hole Depth	Depth to Static Water Level
PVC	65'	10'

TYPE OF COMPLETION: (Circle One or More): Gravel Packed, Underreamed, Telescoped, (Natural Development), Open Hole, Other (Describe)

WELL GROUTED TO A DEPTH OF 20 FEET
Type Grout (circle one): Cement, (Bentonite) or Mix

LOG DATA

TYPE OF LOG RUN (Circle One): (No Log Run) Electric, Gamma Ray, Density, Sonic, Neutron, Other (Describe)

Name of Organization Running Log

GEOLOGIC DATA (Office Use Only)

Surface Elev.	Geologic Unit	Unit Thickness	Depth to Top
Subs. SWL	Date	Analysis	Aquifer Test

Driller's Remarks

SCREEN DATA

Diameter - Inches	Length - Feet	Slot Size - Inches
2"	10'	.004

Screen Type	Depth to Bottom - Feet
PVC Wrapped	65'

Top of Lap Pipe or Reduction in Casing: FEET

IF TELESCOPED OR MORE THAN ONE SCREEN: USE BACK PAGE

DESCRIPTION OF FORMATIONS ENCOUNTERED	FROM	TO
Top Soil	0	2
Brown Clay	2	27
gray Coarse	27	65

FORMATIONS (Continued)	FROM	TO

RECEIVED
JUL 21 1997
Dept. of Environmental Quality
Office of Land & Water Resources

IF MORE SPACE IS NEEDED, USE BACK

If well telescopes please sketch and show depths.

GROUND LEVEL

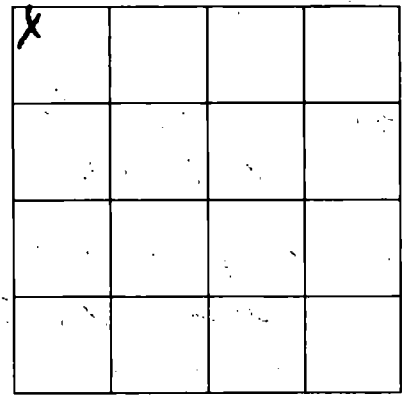

SECTION 10

Please indicate well location X.

ADDITIONAL INFORMATION

If more than one screen, show location of each on sketch.