MISSISSIPPI DEPARTMENT OF ENVIRONMENTAL QUALITY
Office of Land and Water Resources

P. O. Box 10631
Jackson, MS 39289-0631
WATER WELL DRILLERS LOG

COUNTY WELL LOCATED: Jackson	PERMIT NUMBER:
WELL NUMBER: J 2731 — CODED:	NAME OF DRILLING FIRM: Coast Water Well Service
DATE WELL COMPLETED: 4-3-98	

NAME & MAILING ADDRESS OF LANDOWNER
Jackie Massey
Hedgecoth Lane
Ocean Springs, Ms

WELL LOCATION — SEC: 18 — TOWNSHIP: 6 (N) (S) — RANGE: 8 (E) (W)

DISTANCE: 2 Miles — DIRECTION: SE — NEAREST TOWN: of LATIMER

OTHER LANDMARK:

WELL PURPOSE: Home, Irrigation, Municipal, Industrial, Fish Pond, etc.

PUMP DATA

PUMP TYPE (Circle One): Submersible, Turbine, Jet, Flowing Well, Other (Describe) _____

POWER TYPE (Circle One): Electric, Tractor, Diesel, Gasoline, Butane, Other (Describe) _____ H/P 1

Pump Capacity (GPM)	No. of Stages	Setting Depth
8	2	FT.

PUMP TEST

Well yielded _____ GPM with a drawdown of _____ ft. after _____ hours of pumping

WELL DATA

Well Depth	Casing Diameter (In.)	Casing Length (Ft.)
424'	2"	412'
Type of Casing	**Hole Depth**	**Depth to Static Water Level**
PVC	424'	55'

TYPE OF COMPLETION: (Circle One or More): Gravel Packed, Underreamed, Telescoped, Natural Development, Open Hole, Other (Describe) _____

WELL GROUTED TO A DEPTH OF 20 FEET
Type Grout (circle one): Cement, Bentonite or Mix

LOG DATA

TYPE OF LOG RUN (Circle One): Electric, Gamma Ray, Density, Sonic, Neutron, No Log Run, Other (Describe) _____

Name of Organization Running Log

GEOLOGIC DATA (Office Use Only)

Surface Elev.	Geologic Unit	Unit Thickness	Depth to Top
Subs. SWL	Date	Analysis	Aquifer Test

Driller's Remarks

07-30-98 AM 9:45 RCVD

Top of Lap Pipe or Reduction in Casing: FEET

IF TELESCOPED OR MORE THAN ONE SCREEN: USE BACK PAGE

SCREEN DATA

Diameter - Inches	Length - Feet	Slot Size - Inches
2"	10'	.008
Screen Type		**Depth to Bottom - Feet**
PVC		424'

DESCRIPTION OF FORMATIONS ENCOUNTERED	FROM	TO	FORMATIONS (Continued)	FROM	TO
Top Soil	0	3			
Orange Pink gray clay	3	20			
Coarse sand & gravel	20	30			
Blue Clay w/ Sand	30	75			
Fine Coarse sand	75	130			
Blue Clay	130	180			
Coarse sand	180	205			
Blue Clay w/ Shell	205	380			
Coarse sand	380	424			
			IF MORE SPACE IS NEEDED, USE BACK		

If well telescopes please sketch and show depths.

GROUND LEVEL

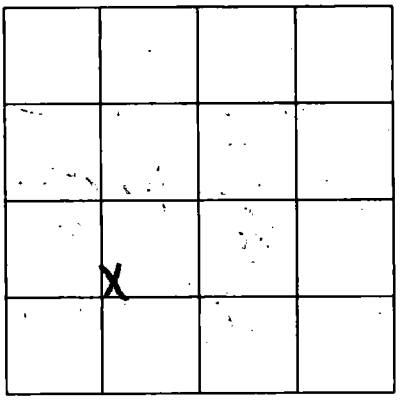

SECTION 18

Please indicate well location X.

ADDITIONAL INFORMATION

If more than one screen, show location of each on sketch.