MISSISSIPPI DEPARTMENT OF ENVIRONMENTAL QUALITY
Office of Land and Water Resources

P. O. Box 10631
Jackson, MS 39289-0631

WATER WELL DRILLERS LOG

COUNTY WELL LOCATED: Jackson	
WELL NUMBER: J 3013	CODED
PERMIT NUMBER	
NAME OF DRILLING FIRM: Coast Water Well Service	
DATE WELL COMPLETED: 12-22-99	

NAME & MAILING ADDRESS OF LANDOWNER
Larry Foreman
Pine Ave
Ocean Springs Ms

WELL LOCATION SEC	TOWNSHIP	RANGE
36	6 (N) (S)	9 (E) (W)

DISTANCE	DIRECTION	NEAREST TOWN
5 Miles	NORTH of	Ocean Springs

OTHER LANDMARK

WELL PURPOSE: (Dom), Irrigation, Municipal, Industrial, Fish Pond, etc.

PUMP DATA

PUMP TYPE (Circle One): Submersible, Turbine, (Jet) Flowing Well, Other (Describe) _____

POWER TYPE (Circle One): (Electric), Tractor, Diesel, Gasoline, Butane, Other (Describe) _____ H/P 1

Pump Capacity (GPM)	No. of Stages	Setting Depth
7	2	FT.

PUMP TEST

Well yielded _____ GPM with a drawdown of _____ ft. after _____ hours of pumping

WELL DATA

Well Depth	Casing Diameter (In.)	Casing Length (Ft.)
200'	2"	190

Type of Casing	Hole Depth	Depth to Static Water Level
PVC	200'	40'

TYPE OF COMPLETION: (Circle One or More): Gravel Packed, Underreamed, Telescoped, (Natural Development), Open Hole, Other (Describe) _____

WELL GROUTED TO A DEPTH OF 20 FEET
Type Grout (circle one): Cement, (Bentonite), or Mix

LOG DATA

TYPE OF LOG RUN (Circle One): Electric, Gamma Ray, Density, Sonic, Neutron, (No Log Run), Other (Describe) _____

Name of Organization Running Log

GEOLOGIC DATA (Office Use Only)

Surface Elev.	Geologic Unit	Unit Thickness	Depth to Top
Subs. SWL	Date	Analysis	Aquifer Test

Driller's Remarks

Top of Lap Pipe or Reduction in Casing
FEET — IF TELESCOPED OR MORE THAN ONE SCREEN: USE BACK PAGE

SCREEN DATA

Diameter - Inches	Length - Feet	Slot Size - Inches
2"	10'	.004

Screen Type	Depth to Bottom - Feet
PVC Wrapped	200'

DESCRIPTION OF FORMATIONS ENCOUNTERED	FROM	TO	FORMATIONS (Continued)	FROM	TO
Top Soil	0	3			
Orange Clay	3	20			
Coarse Sand Gravel	20	35			
Blue Clay	35	66			
Med Sand	66	86			
Blue Clay	86	185			
Med Sand	185	200			
			IF MORE SPACE IS NEEDED, USE BACK		

If well telescopes please sketch and show depths.

GROUND LEVEL

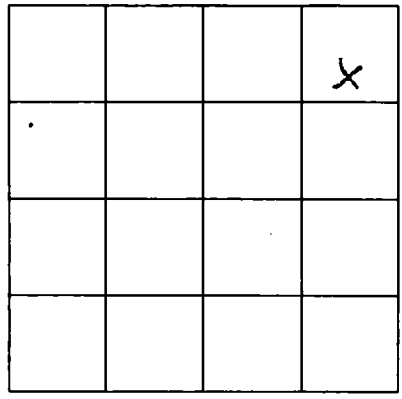

SECTION 36

Please indicate well location X.

ADDITIONAL INFORMATION

If more than one screen, show location of each on sketch.