JACKSON
K 59
4-68

MISSISSIPPI
BOARD OF WATER COMMISSIONERS
416 North State Street
Jackson, Mississippi 39201

WATER WELL DRILLERS LOG

4-16-68 19 COAST WATER WELL SERVICE JACKSON
date well completed — firm name — county well located

LANDOWNER: Willie Horne
Gen. Del.
Vaughan, Miss.
(mailing address)

WELL LOCATION:
sec. 4 T. 6 N/S R. 7 E/W
1½ miles North of Vaughan
(distance) (direction) (nearest town)

WELL PURPOSE: Home
(home, irrigation, municipal, industrial)

WELL COMPLETION DATA:

(1) diameter (inches) 2"
(2) total depth (feet) 88'
(3) static water level (feet) 35' below ~~above~~ top of ground.
(4) casing GALV. (material), 84' (depth), 2" (size) If telescope see back.
(5) screen 4' (length), 84' (depth to top), 2" (size), PLASTIC (material)
(6) pump — (HP) 5 (yield gpm)
Elect (type power)
(7) electric log No (yes or no)
(organization running log)
(8) how well bottom plugged 2" BACK WASH VALVE

DRILLERS REMARKS:

description of formations encountered	from	to
RED CLAY + PINK SILT	0	13
FINE SAND	13	17
BLUE-GRAY CLAY	17	56
MED. SAND	56	88

MAY 17 1968
MISS. BD. OF WATER COMM.

If well telescopes please sketch and show depths.

GROUND LEVEL

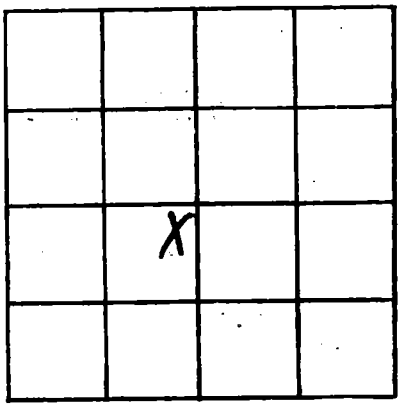

SECTION 4

Please indicate well location X.

ADDITIONAL INFORMATION

If more than one screen, show locations of each on sketch.