JACKSON
K 104
7-11-72

MISSISSIPPI
BOARD OF WATER COMMISSIONERS
416 North State Street
Jackson, Mississippi 39201

WATER WELL DRILLERS LOG

July 11 19 72 Coast Water Well Serv. Jackson
date well completed — firm name — county well located

Robert

LANDOWNER: Wilson
Rt. 1 Box 130
Ocean Springs, Miss
(mailing address)

WELL LOCATION:
sec. 9 T 6 N S R 7 E W
in Vancleave
miles (distance) (direction) of (nearest town)

WELL PURPOSE: Home
(home, irrigation, municipal, industrial)

WELL COMPLETION DATA:

(1) diameter (inches) 2"
(2) total depth (feet) 270'
(3) static water level (feet) 50' below ~~above~~ top of ground.
(4) casing PVC (material), 260' (depth), 2" (size) If telescope see back.
(5) screen 10' (length), 260' (depth to top), 2" (size), PVC (material)
(6) pump 1 (HP) 60 (yield gpm)
elec (type power)
(7) electric log NO (yes or no)
(organization running log)
(8) how well bottom plugged
~~backwash valve~~

DRILLERS REMARKS:

description of formations encountered	from	to
top soil	0	10
med. sand	10	50
yellow clay	50	80
fine sand	80	95
Blue clay	95	240
med. to coarse sand	240	270

CODED

If well telescopes please sketch and show depths.

GROUND LEVEL

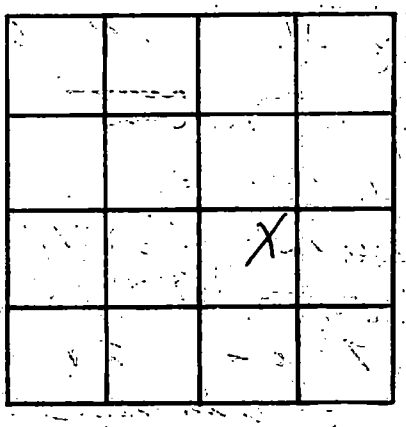

SECTION 9

Please indicate well location X.

ADDITIONAL INFORMATION

If more than one screen, show locations of each on sketch.