Jackson
K 2216

MISSISSIPPI DEPARTMENT OF NATURAL RESOURCES
Bureau of Land and Water Resources
Southport Mall
P.O. Box 10631
Jackson, Mississippi 39209

WATER WELL DRILLERS LOG

6-2-86 19 — date well completed
Coast water well — firm name
Jackson — county well located

LANDOWNER: AD Ellzie
Rt 10 Box 215
Laurel MS 39440
(mailing address)

WELL LOCATION:
sec. 25 T 6 (N) (S) R 7 (E) (W)
4 (distance) miles SE (direction) of Vancleave (nearest town)

WELL PURPOSE: home
(home, irrigation, municipal, industrial)

WELL COMPLETION DATA:
(1) diameter (inches) 2"
(2) total depth (feet) 135'
(3) static water level (feet) 45 below ~~above~~ top of ground.
(4) casing PVC (material), 120' (depth), 2" (size) if telescope see back.
(5) screen 10' (length), 120' (depth to top), 2" (size), PVC (material)
(6) pump 1 (HP) 8 (yield gpm) Elect (type power)
(7) electric log no (yes or no)
(organization running log)
(8) how well bottom plugged backwash valve

DRILLERS REMARKS: 5'-2" Tailpipe

description of formations encountered	from	to
Top Soil	0	2
Brown Clay	2	30
White Coarse Sand	30	70
Brown Clay	70	73
Salt + Pepper med sand.	73	130
Pea Gravel	130	135

120
10
130

RECEIVED
AUG 20 1986
Department of Natural Resources
Bureau of Land & Water Resources

If well telescopes please sketch and show depths.

GROUND LEVEL

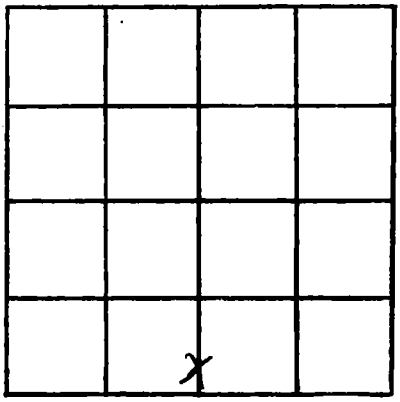

SECTION 25

Please indicate well location X.

ADDITIONAL INFORMATION

If more than one screen, show locations of each on sketch.