MISSISSIPPI DEPARTMENT OF NATURAL RESOURCES

Bureau of Land and Water Resources

P.O. Box 10631
Jackson, Mississippi 39209

WATER WELL DRILLERS LOG

COUNTY WELL LOCATED	Jackson
WELL NUMBER	K 2269
CODES	
DATE WELL COMPLETED	6-17-88
PERMIT NUMBER	
NAME OF DRILLING FIRM	Coast Water Well Serv. Inc

NAME & MAILING ADDRESS OF LANDOWNER
Patsy Miller
2431 DH SMITH RD
VANCLEAVE MS

WELL LOCATION: SEC 14 TOWNSHIP 6 ~~N~~ S RANGE 7 ~~E~~ W

DISTANCE 2 1/2 Miles DIRECTION SE of NEAREST TOWN VANCLEAVE

OTHER LANDMARK

WELL PURPOSE: Home, Irrigation, Municipal, Industrial, Fish Pond, etc.
home

PUMP DATA

PUMP TYPE (Circle One): Submersible, Turbine, (Jet) Flowing Well, Other (Describe) ____

POWER TYPE (Circle One): (Electric) Tractor, Diesel, Gasoline, Butane, Other (Describe) ____

Pump Capacity (GPM)	No. of Stages	Setting Depth
7	—	— FT.

PUMP TEST

Well yielded — GPM with

a drawdown of — ft.

after — hours of pumping

WELL DATA

Well Depth	Casing Diameter (In.)	Casing Length (Ft.)
130'	2 1/2"	115'
Type of Casing	**Hole Depth**	**Depth to Static Water Level**
PVC	130	50'

TYPE OF COMPLETION: (Circle One or More): Gravel Packed, Underreamed, Telescoped, (Natural Development), Open Hole, Other (Describe) ____

Top of Lap Pipe or Reduction in Casing FEET

IF TELESCOPED OR MORE THAN ONE SCREEN: USE BACK PAGE

LOG DATA

TYPE OF LOG RUN (Circle One): (No Log Run), Electric, Gamma Ray, Density, ~~Sonic~~, ~~Neutron~~, Other (Describe) ____

Name of Organization Running Log

GEOLOGIC DATA (Office Use Only)

Surface Elev.	Geologic Unit	Unit Thickness	Depth to Top
Subs. SWL	Date	Analysis	Aquifer Test

Driller's Remarks

SCREEN DATA

Diameter - Inches	Length - Feet	Slot Size - Inches
2"	10'	.008
Screen Type		**Depth to Bottom - Feet**
PVC		125'

RECEIVED
NOV 15 1988
Department of Natural Resources
Bureau of Land & Water Resources

DESCRIPTION OF FORMATIONS ENCOUNTERED	FROM	TO
Top Soil	0	2
White Coarse Sand	2	21
Blue Clay	21	86
Gray Med Sand	86	125
Blue Clay	125	130

FORMATIONS (Continued)	FROM	TO

IF MORE SPACE IS NEEDED, USE BACK

If well telescopes please
sketch and show depths.

GROUND LEVEL

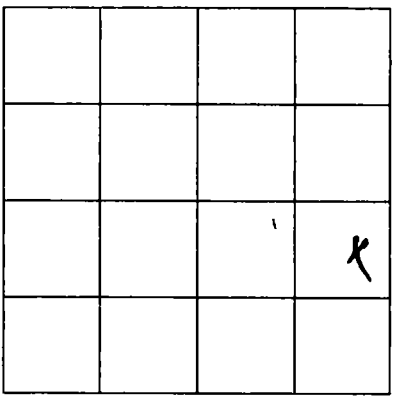

SECTION 14

Please indicate well location X.

ADDITIONAL INFORMATION

If more than one screen,
show location of each on sketch.