MISSISSIPPI DEPARTMENT OF NATURAL RESOURCES

Bureau of Land and Water Resources

P.O. Box 10631
Jackson, Mississippi 39209

WATER WELL DRILLERS LOG

COUNTY WELL LOCATED: Jackson	
WELL NUMBER: R92783	CODED
DATE WELL COMPLETED: 6-22-89	
PERMIT NUMBER	
NAME OF DRILLING FIRM: Coast Water Well Ser Inc.	

NAME & MAILING ADDRESS OF LANDOWNER
Allen Jew
Imabiscette Rd
Vaughan Ms

WELL LOCATION: SEC. 12 TOWNSHIP 6 (N) (S) RANGE 7 (E) (W)

DISTANCE 2 1/2 Miles DIRECTION EAST of NEAREST TOWN VANCLEAVE

OTHER LANDMARK

WELL PURPOSE: Home, Irrigation, Municipal, Industrial, Fish Pond, etc.
Home

PUMP DATA

PUMP TYPE (Circle One): Submersible, Turbine, Jet, Flowing Well, Other (Describe)

POWER TYPE (Circle One): Electric, Tractor, Diesel, Gasoline, Butane, Other (Describe) H/P Thep.

Pump Capacity (GPM)	No. of Stages	Setting Depth
12	2	FT.

PUMP TEST

Well yielded _____ GPM with a drawdown of _____ ft. after _____ hours of pumping

WELL DATA

Well Depth	Casing Diameter (In.)	Casing Length (Ft.)
120' 115	2"	105'
Type of Casing	**Hole Depth**	**Depth to Static Water Level**
	120'	30'

TYPE OF COMPLETION: (Circle One or More): Gravel Packed, Underreamed, Telescoped, Natural Development, Open Hole, Other (Describe)

Top of Lap Pipe or Reduction in Casing FEET

IF TELESCOPED OR MORE THAN ONE SCREEN: USE BACK PAGE

LOG DATA

TYPE OF LOG RUN (Circle One): Electric, Gamma Ray, Density, Sonic, Neutron, Other (Describe) No Log Run.

Name of Organization Running Log

GEOLOGIC DATA (Office Use Only)

Surface Elev.	Geologic Unit	Unit Thickness	Depth to Top
Subs. SWL	Date	Analysis	Aquifer Test

Driller's Remarks

SCREEN DATA

Diameter - Inches	Length - Feet	Slot Size - Inches
2"	10'	.008
Screen Type		**Depth to Bottom - Feet**
PVC		115'

DESCRIPTION OF FORMATIONS ENCOUNTERED	FROM	TO	FORMATIONS (Continued)	FROM	TO
Top Soil	0	1			
Red Clay	1	11			
Red Coarse sand	11	43			
Blue Clay	43	84			
Wt. Coarse sand	84	90			
Brown Med. Sand	90	103			
Brown Coarse sand	103	117			
Blue Clay	117	120	Department of Natural Resources		
			Bureau of Land & Water Resources		
			IF MORE SPACE IS NEEDED, USE BACK		

If well telescopes please
sketch and show depths.

GROUND LEVEL

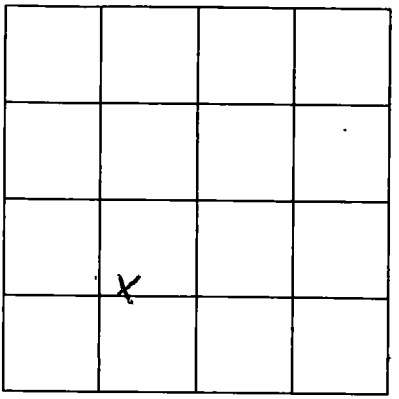

SECTION 12.

Please indicate well location X.

ADDITIONAL INFORMATION

If more than one screen,
show location of each on sketch.