MISSISSIPPI DEPARTMENT OF NATURAL RESOURCES

Bureau of Land and Water Resources

P.O. Box 10631
Jackson, Mississippi 39209

WATER WELL DRILLERS LOG

COUNTY WELL LOCATED: Jackson

WELL NUMBER: K7985 | CODED:

PERMIT NUMBER:

NAME OF DRILLING FIRM: Coast Water Well Serv.

DATE WELL COMPLETED: 5-21-89

NAME & MAILING ADDRESS OF LANDOWNER
Telanico Construction
111 Hunter Dr.
Ocean Springs, Ms.

WELL LOCATION: SEC. 18 TOWNSHIP 6 (N) (S) RANGE 7 (E) (W)

DISTANCE 2 Miles DIRECTION SE of NEAREST TOWN VANCLEAVE

OTHER LANDMARK

WELL PURPOSE: Home, Irrigation, Municipal, Industrial, Fish Pond, etc.
Home

PUMP DATA

PUMP TYPE (Circle One):
Submersible, Turbine, (Jet) Flowing Well,
Other (Describe)

POWER TYPE (Circle One):
(Electric), Tractor, Diesel, Gasoline, Butane,
Other (Describe) H/P 1 h.p.

Pump Capacity (GPM)	No. of Stages	Setting Depth
6	2	FT.

PUMP TEST

Well yielded _____ GPM with

a drawdown of _____ ft.

after _____ hours of pumping

WELL DATA

Well Depth	Casing Diameter (In.)	Casing Length (Ft.)
525	2"	495'

Type of Casing	Hole Depth	Depth to Static Water Level
PVC	525'	85'

TYPE OF COMPLETION: (Circle One or More):
Gravel Packed, Underreamed, Telescoped,
Natural Development, Open Hole, Other
(Describe)

Top of Lap Pipe or Reduction in Casing

FEET

IF TELESCOPED OR MORE THAN ONE SCREEN: USE BACK PAGE

SCREEN DATA

Diameter - Inches	Length - Feet	Slot Size - Inches
2"	20'	.008

Screen Type	Depth to Bottom - Feet
PDC	515'

LOG DATA

TYPE OF LOG RUN (Circle One): (No Log Run),
Electric, Gamma Ray, Density, Sonic, Neutron,
Other (Describe)

Name of Organization Running Log

GEOLOGIC DATA (Office Use Only)

Surface Elev.	Geologic Unit	Unit Thickness	Depth to Top
Subs. SWL	Date	Analysis	Aquifer Test

Driller's Remarks

DESCRIPTION OF FORMATIONS ENCOUNTERED	FROM	TO
Top Soil	0	7
Red Clay	7	16
Red Sand	16	25
Gray Clay	25	45
Med. Sand	45	60
Blue Clay	60	115
Fine to Med S-	115	185
Blue Clay & Stks		
Of Sand	185	400
Fine Sand	400	420
Blue Clay	420	450

FORMATIONS (Continued)	FROM	TO
Fine to Med Sand	450	525

RECEIVED
NOV 21 1989
Department of Natural Resources
Bureau of Land & Water Resources

IF MORE SPACE IS NEEDED, USE BACK

If well telescopes please sketch and show depths.

GROUND LEVEL

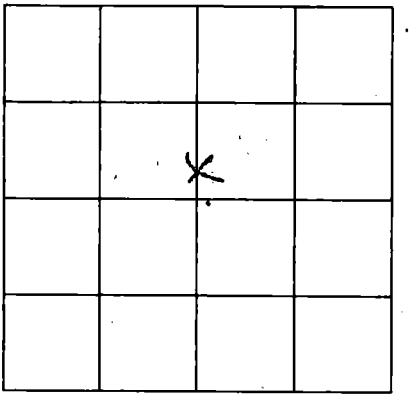

SECTION 18

Please indicate well location X.

ADDITIONAL INFORMATION

If more than one screen, show location of each on sketch.